


Section 11 - Township 31 Range 4-E

Well No. 2 Sherwood

Company Roth Oil & Gas

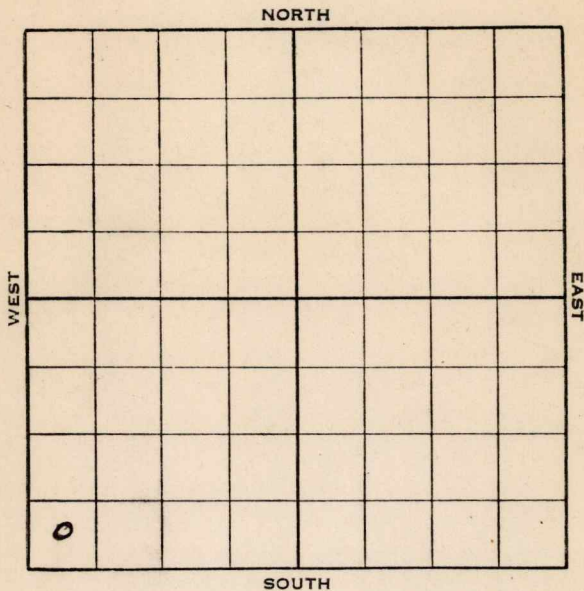

Sec. 11 Twp. 31 R. 4-E

Well No. #2 Sherwood Farm

Roth Oil & Gas Company


NORTH

\_\_\_\_\_ Ft. from N. Line

330 Ft. from S. Line

\_\_\_\_\_ Ft. from E. Line

330 Ft. from W. Line

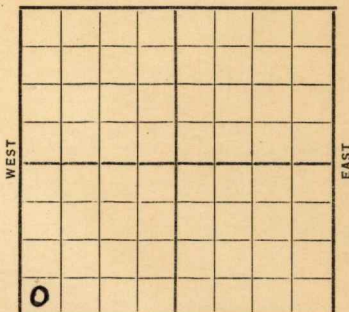

**Elev. 1274**

Date	REPORT
1938	
7/13	Machine.
7/22	Spud.
7/29	20" - 40'. 15" - 455'.
	Fsg. 720'.
8/5	12" - 911'. Dlg. 1200'.
8/12	Dlg. 1508'.
8/19	10" - 1550'. Dlg. 1660'.
8/26	T. D. 1735'. U. R. 10".
9/2	10" - 1684'. T. D. 1745'. C. O.
9/9	SD 2015'.
9/16	Fsg. 2015'.
9/23	" "
9/30	" "
10/7	" "
10/14	Rng. 8".
10/21	Fsg.
10/28	8" - 2075'. Dlg. 2090'.
11/4	Drlg. 2520'.
11/12	5" - 2766'. Dlg. 2820'.
11/18	5" - 2870'. Dlg. 2890'.

**OVER**

1938

11/25 5" - 2963'. WOC.

12/2 Bart. 2973'. T. D. 2982' S. O.  
Shot 20 qts. 2966-76'. C. O.

12/9 Swab 15 oil in 24 hours.

12/13 5" - 2963'.

Bart. 2973' ~~(Corrected)~~

T. D. 2982'.

Shot 20 qts.

15 bbls. oil.

COMPLETED

Cowley **KANSAS**

Map No. 2 Sec. 11 Twp. 31 R. 4E

Well No. 2 Sherwood

Roth Oil & Gas Company

Contractor

FIRST REPORT

SECTION PLAT

SW/C

\_\_\_\_\_ Ft. from N. Line  
330 Ft. from S. Line  
 \_\_\_\_\_ Ft. from E. Line  
330 Ft. from W. Line

0			

Location \_\_\_\_\_

Rig up \_\_\_\_\_

Drilling and Remarks:

**Mach**

RECORD

Cased \_\_\_\_\_ in., \_\_\_\_\_ ft.

Sand \_\_\_\_\_

Gas \_\_\_\_\_

Oil \_\_\_\_\_

Total Depth \_\_\_\_\_

PRODUCTION

1st 24 hrs. Nat. \_\_\_\_\_

1st 24 hrs. after shot \_\_\_\_\_

Gas \_\_\_\_\_ Cu. Ft.

Dry Hole \_\_\_\_\_

Abandoned \_\_\_\_\_

Date

JUL 13 1938 19

H. D. Hatfield Scout

Cowley

KANSAS

Map No. 2 Sec. 11 Twp. 31 R. 4E

Well No. 2 Sherwood

Roth Oil & Gas

Company

Contractor

**COMPLETED**

SW/C

**SECTION PLAT**

0			

         Ft. from N. Line

330 Ft. from S. Line

         Ft. from E. Line

330 Ft. from W. Line

Location                                 

Rig up                                 

Drilling and Remarks:

*Shot 20 gts*

*15 bbls*

**RECORD**

Cased 5 in., 296.3 ft.

Sand Bart 2973

Gas                                  *corrected*

Oil                                 

Total Depth 2982

**PRODUCTION**

1st 24 hrs. Nat.                                 

1st 24 hrs. after shot                                 

Gas                                  Cu. Ft.

Dry Hole                                 

Abandoned                                 

Date

DEC 13 1938 19

H. D. Hatfield

Scout