

Section 35 Township 20 Range 12W

Well No. 1 Kormarek

Company Cities Service

Workman

NORTH

			0				

WEST

EAST

SOUTH

Barton

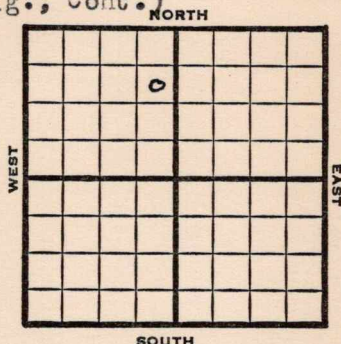
KANSAS

Sec. 35 Twp. 20 R. 12WWell No. #1 Kormarek Farm

Cities Service

Workman (Transit Drlg., Cont.) Company

Pool

990' Ft. from N. Line Ft. from S. Line330' Ft. from E. Line Ft. from W. Line

SE NE NW

1949

Elev 1841'

REPORT

7/20 Location

7/27 "

8/3 "

8/10 8"@ 228'

Drlg 1410'

8/17 Drlg 3240'

8/24 Lansing 3146'

Arbuckle 3384-5" @ 3385'

TD 3396' - 500 acid

8/31 Pump 131 bbls oil 24 hrs.

9/7 "

9/14 TD 3396'

Arb. 3384'

5"@ 3385'

Pump 131 Oil Pot

Gr 37°

Comp

COMPLETED

Map No. _____ Sec. 35 Twp. 20 R. 12WWell No. 1 Kormarek

Cities Service

Company

Transit Drlg.

Contractor

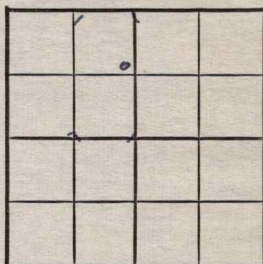
SE NE NW

FIRST REPORT
SECTION PLAT990 Ft. from N. Line

_____ Ft. from S. Line

330 Ft. from E. Line

_____ Ft. from W. Line



Barton County

Location X

Rig up _____

Drilling and Remarks:

RECORD

Cased _____ in., _____ ft.

Sand _____

Gas _____

Oil _____

Total Depth _____

PRODUCTION

1st 24 hrs. Nat. _____

1st 24 hrs. after shot _____

Gas _____ Cu. Ft.

Dry Hole _____

Abandoned _____

Date

JUL 20 1949

19

S. J. LEWIS

Scout

Kansas

Workman Pool

Map No. K46 Sec. 35 Twp. 20 R. 12WWell No. 1 Kormarek

Cities Service

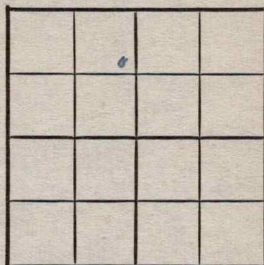
Company

COMPLETE

Contractor

SE NE NW

SECTION PLAT

990 Ft. from N. Line Ft. from S. Line330 Ft. from E. Line Ft. from W. Line

Barton County

Location Rig up

Drilling and Remarks:

Cu X 33845" C 3385.Prod 181 oil 1st37-1/2**RECORD**Cased in., ft.Sand Gas Oil Total Depth 3396**PRODUCTION**1st 24 hrs. Nat. 1st 24 hrs. after shot Gas Cu. Ft.Dry Hole Abandoned

Date

SEP 14 1949

19

S. J. LEWIS

Scout