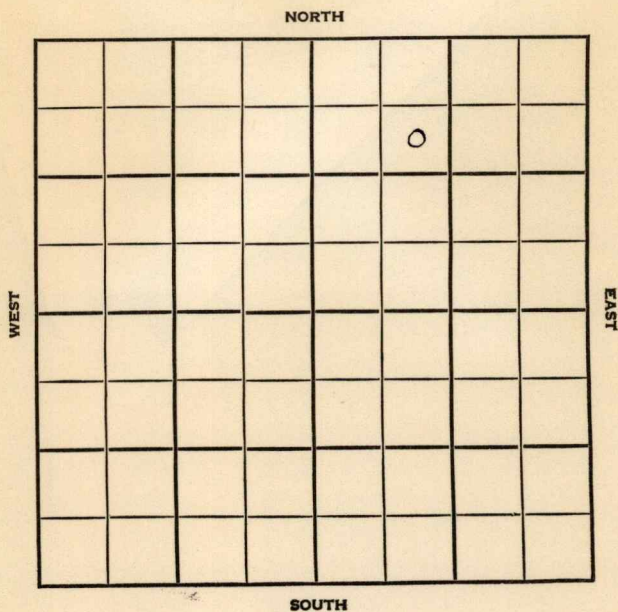


Section 11 Township 31 S Range 4 EWell No. #3 LewisCompany Earl Wakefield

Cowley

KANSAS

SEC.

11

TWP.

31S

R.

4E

WELL NO.

#3 Lewis

FARM

COMPANY

Earl Wakefield

CONTRACTOR

Co Tools

David


Ft. from N. Line

Ft. from S. Line

Ft. from E. Line

Ft. from W. Line

NORTH

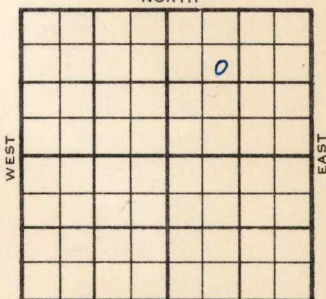

SE NW NE

SOUTH

1955

ELEVATION

1307'

REPORT

9/28

Loc

10/26

Comm 9-27-55

8 5/8" @ 100

5 1/2" @ 3000 w/75

Totan 2005

Stal 2015

KC 2389

Oswego 2695

Bart 2999

CO to 3011 1/2 frac Comp 25 bopd

COMPLETED

County Cowley

Elev.

1307

Sec. 11

Twp.

31

Rge.

4E

Company

Earl Wakefield

Farm Name

Lewis

No.

3

TOPS

DEPTH

LOG

DATUM

Loc. in Sec.

Anh.

Tp. JotawH. Hal

Tr.

Dg.

Bl.

L.

K.C.

B.K.C. DavegoC. Barto

C.

M.

M.

K.

Mz.

Me.

V.

S.

S.

A.

R.

Pc.

G.

T.D.

2005

2015

698

708

2389

2695

2999

1082

1388

1692

Geol.

Contr.

Co. tools

Pool

David

COMPLETE

Date Comm. 9-27-55

OCT 26 1955

8 5/8" @ 100 5 1/2" @ 3000/75

CO to 3011 frac Comp. 25 bopd

Elev.

Twp.

318

Rae.

LE

Farm Name Lewis

No. 3

Use

SE NW NE

Geol.

Contr

Co. tools

Pool

Da vid

FIRST REPORT

No.

Date Comm.

Loc.

SEP 28 1955

Sec


