

KANSAS Woodson




Section 34 Township 25 Range 15-E

Well No. #1 Laidlow

Company Barker et al

NORTH Miscellaneous

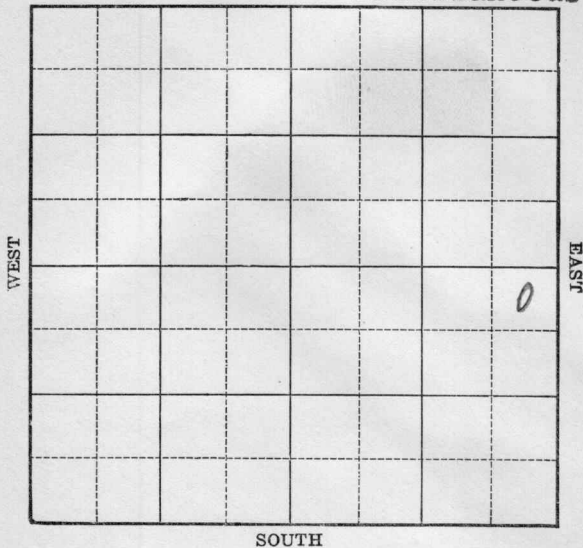

Sec. 34 Twp. 25 R. 15-E

Well No. #1 Laidlow Farm

Barker et al Company


(Misc.)

330 Ft. from N. Line

_____ Ft. from S. Line

330 Ft. from E. Line

_____ Ft. from W. Line

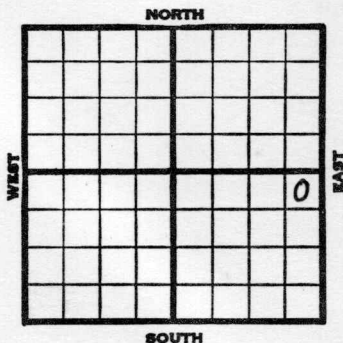

1940	REPORT
1/10	Drlg. 1400'
1/18	Miss. 1414' 6" - 1414'
	Pay 1415-21' T.D.
	Pump 15 bbls. a day.
1/25	Shut down.
2/1	" "
2/8	1000 acid. No test.
2/14	Miss. 1414'
	6" - 1414'
	T.D. 1421'
	1000 acid.
	Pump 28 bbls.
	COMPLETED

Map No. 17 Sec. 34 Twp. 25 R. 15E

Well No. 1 Laidlow

Barker etal Company

Contractor

FIRST REPORT

NE SE

330 Ft. from N. Line

_____ Ft. from S. Line

330 Ft. from E. Line

_____ Ft. from W. Line

SECTION PLAT

			0

MISCELLANEOUS

Location _____

Rig up _____

Drilling and Remarks:

Dr lg. 1400

RECORD

Cased _____ in., _____ ft.

Sand _____

Gas _____

Oil _____

Total Depth _____

PRODUCTION

1st 24 hrs. Nat. _____

1st 24 hrs. after shot _____

Gas _____ Cu. Ft.

Dry Hole _____

Abandoned _____

Date

JAN 10 1940 19

S. J. LEWIS Scout

Map No. 17 Sec. 34 Twp. 25 R. 15E

Well No. 1 Laidlow

Barker etal Company

Contractor

COMPLETED

NE SE

330 Ft. from N. Line

_____ Ft. from S. Line

330 Ft. from E. Line

_____ Ft. from W. Line

SECTION PLAT

MISCEL LANEOUS

Location _____

Rig up _____

Drilling and Remarks:

*Miss 1414
6" @ 1414.
1000 acioil
Pump 2588 1/2*

RECORD

Cased _____ in., _____ ft.

Sand _____

Gas _____

Oil _____

Total Depth 1421

PRODUCTION

1st 24 hrs. Nat. _____

1st 24 hrs. after shot _____

Gas _____ Cu. Ft.

Dry Hole _____

Abandoned _____

Date

FEB 1 1940 19

S. J. LEWIS Scout