


Section 35 Township 25 Range 15-E

Well No. #1 Lewis

Company C. H. Barker

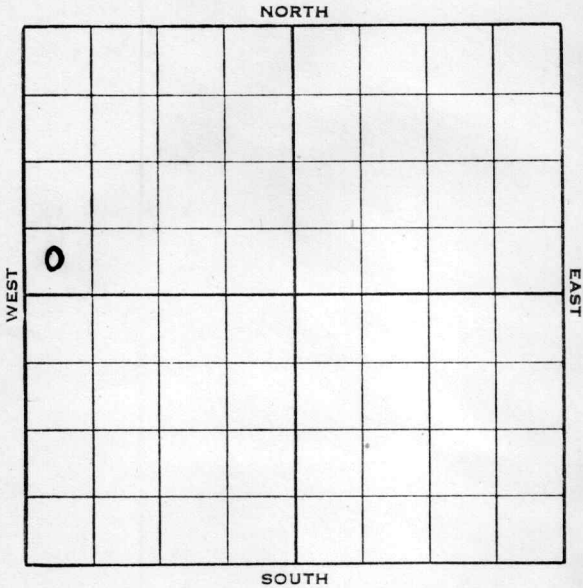

KANSAS

Woodson

Sec. 35 Twp. 25 R. 15-E

Well No. #1 Lewis Farm


C. H. Barker Company

SW NW
Ft. from N. Line

330 Ft. from S. Line

Ft. from E. Line

330 Ft. from W. Line

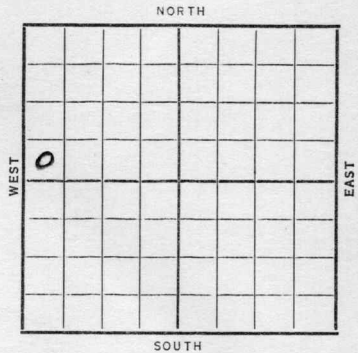

Date	REPORT
1938	
6/29	Dlg. 950 8" 664
7/8	Shut down.
7/15	" "
7/22	SD 1250'.
7/27	5" - 1426'.
	Miss. 1426'.
	T. D. 1485'.
	ABANDONED

Map No. 17 Sec. 35 Twp. 25 R. 15E

Well No. 1 Lewis

C. H. Barker Company

Contractor

FIRST REPORT

SECTION PLAT

SW NW

_____ Ft. from N. Line

330 Ft. from S. Line

_____ Ft. from E. Line

330 Ft. from W. Line

0			

Location _____

Rig up _____

Drilling and Remarks:

8" - 664

Dr 1g. 950

RECORD

Cased _____ in., _____ ft.

Sand _____

Gas _____

Oil _____

Total Depth _____

PRODUCTION

1st 24 hrs. Nat. _____

1st 24 hrs. after shot _____

Gas _____ Cu. Ft.

Dry Hole _____

Abandoned _____

Date

JUN 29 1938 19

H. D. Hatfield Scout

Map No. 17 Sec. 35 Twp. 25 R. 15E

Well No. 1 Lewis

C. H. Barker Company

Contractor

ABANDONED

SW NW

SECTION PLAT

0			

 Ft. from N. Line

330 Ft. from S. Line

 Ft. from E. Line

330 Ft. from W. Line

Location

Rig up

Drilling and Remarks:

DNA

RECORD

Cased 5 in., 1426 ft.

Sand MISS 1426

Gas

Oil

Total Depth 1485

PRODUCTION

1st 24 hrs. Nat.

1st 24 hrs. after shot

Gas Cu. Ft.

Dry Hole

Abandoned

Date

JUL 27 1938

19

Scout