


Section 11 Township 31 Range 4E

Well No. 5 Lewis

Company McNeish & Garlapp

NORTH

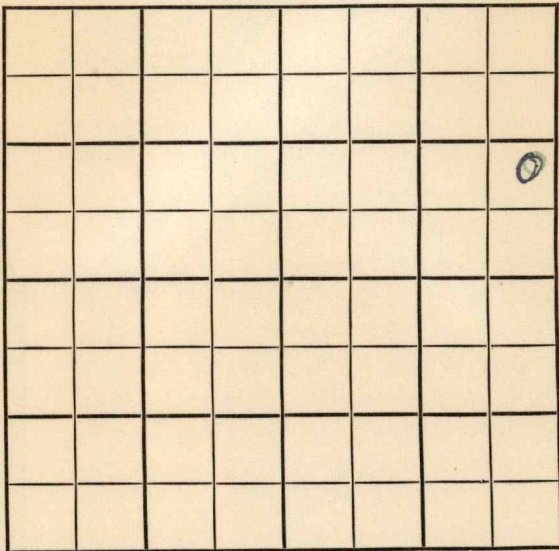

SOUTH

WEST

EAST

Cowley

KANSAS

SEC. 11	TWP. 31	R. 4E
------------	------------	----------

WELL NO. #5 Lewis FARM

COMPANY M^cNeish & Gralapp

CONTRACTOR Watson

DAvid


_____ Ft. from N. Line

_____ Ft. from S. Line

_____ Ft. from E. Line

_____ Ft. from W. Line

NE SE NE

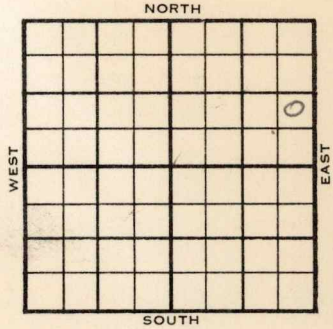

1955	ELEVATION 1289'	REPORT
------	--------------------	--------

7/6 Comm 7-5-55
8" @ 100/100

8/10 5 1/2" @ 2953/75 CO to 2983 FU 650' dil,
16 hr. frac Comp: 25 bopd
Bl. Bart: 2951, 1662; KC: 2344, 1055;
BKC Oswego 2720, 1431; TD: 2983;

COMPLETED

County Cowley Elev. _____
 Sec. 11 Twp. 31 Rge. 4E
 Company McNeish & Gralapp
 FarmName Lewis No. 5

TOPS	DEPTH	LOG	DATUM
Anh.			
TP.			
H.			
Tr.			
Dg.			
BL.			
L.			
K.C.			
B.K.C.			
Ce.			
C.			
M.			
M.			
K.			
Mz.			
Me.			
V.			
S.			
S.			
A.			
R.			
PE.			
G.			
T.D.			

Loc. in Sec. _____

NE SE NE

Geol. _____

Contr. _____

Watson

Pool _____

David

		0
FIRST REPORT		
JUL 6 '55		

Date Comm. 7-5-55

8" @ 100/100

Co.

Lse.

No.

Sec.

T.

R.

County Cowley Elev. 1289
 Sec. 11 Twp. 31 Rge. 4E
 Company McNeish & Gralapp
 Farm Name Lewis No. 5

TOPS	DEPTH	LOG	DATUM
Anh.			
Tp.			
H.			
Tr.			
Dg.			
Bl.	<u>Bart</u>	<u>2957</u>	<u>1662</u>
L.			
K.C.		<u>2344</u>	<u>1055</u>
B.K.C.	<u>Oswego</u>	<u>2720</u>	<u>1431</u>
Ce.			
C.			
M.			
M.			
K.			
Mz.			
Mq.			
V.			
S.			
S.			
A.			
R.			
PE.			
G.			
T.D.	<u>2983</u>		

Loc. in Sec. NE SE NE
 Geol. _____
 Contr. Watson
 Pool David

COMPLETE

Date Comm. 7-5-55 AUG 10 1955
8" @ 100/100 5 1/2" @ 2953/75 CO to 2983
FU 650' oil 16 hr. frac
Comp. 25 bopd

Co.
Lse.
No.
Sec.
T.
R.