

Cowley

KANSAS

SECTION 11 TOWNSHIP 31 RANGE 4 E

WELL NO. #7 Lewis

COMPANY McNeish & Gralapp

NORTH

						0	

WEST

EAST

SOUTH

Cowley

KANSAS

SEC.	TWP.	R.
11	31	4E

WELL NO.

#7 Lewis

FARM

COMPANY

McNeish & Gealapp

CONTRACTOR

Watson

NW David


Ft. from N. Line

Ft. from S. Line

Ft. from E. Line

Ft. from W. Line

NW SE NE

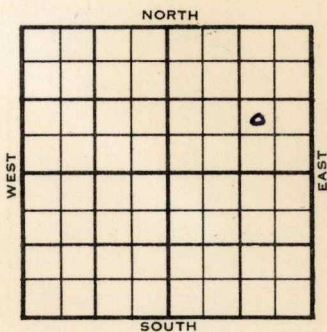

	ELEVATION	REPORT
1955	1284	
11/16	M I R	
12-7	Comm. 11-16-55 8 5/8" @ 103/90 5 1/2" @ 2964 CO to 2986 10 bopd, frac Comp. 25 bopd Stal 1980 KC 2350 Oswego 2604 Bart 2963 TD 2986'	

COMPLETED

County **Cowley** Elev. _____
 Sec. **11** Twp. **31** Rge. **4E**
 Company **McNeish & Gralapp**
 Farm Name **Lewis** No. **7**

TOPS	DEPTH	LOG	DATUM	Loc. in Sec.
Anh.				NW SE NE
Tp.				
H.				
Tr.				
Dg.				
Bl.				
L.				Geol.
K.C.				Contr.
B.K.C.				Watson
Ce.				Pool
C.				NW David
M.				
M.				
K.				
Mz.				
Me.				
V.				
S.				
S.				
A.				
R.				
Pe.				
G.				
T.D.				

FIRST REPORT

NOV 19 1955

NOV 16 1955

Date Comm.

M I R

Co.

Lse.

No.

Sec.

T.

R.

County Cowley Elev. 1284
 Sec. 11 Twp. 31 Rge. 4E
 Company McNeish & Gralapp
 Farm Name Lewis No. 7

TOPS	DEPTH	LOG	DATUM	Loc. in Sec.
Anh.				NW SE NE
TP.				
H. <u>Stal</u>	<u>1980</u>		<u>696</u>	
Tr.				
Dg.				
BL.				
L.				
K.C. <u>2350</u>			<u>1066</u>	Geol.
B.K.C. <u>2604</u>			<u>1320</u>	Contr.
Ce. <u>Bart</u>	<u>2963</u>		<u>1679</u>	Watson
C.				
M.				
M.				Pool
K.				NW David
Mz.				
Mq.				
V.				
S.				
S.				
A.				
R.				
Pe.				
G.				
TD.	<u>2986</u>			

Date Comm. 11-16-55

DEC 7 1955

8 5/8" @ 103/90 5 1/2" @ 2964 CO to 2986

10 bopd frac Comp. 25 bopd