FORM 51


KANSAS

Woodson

Section 36 Township 25 Range 15E

Well No. 1 Laidlow

Company Bert Young

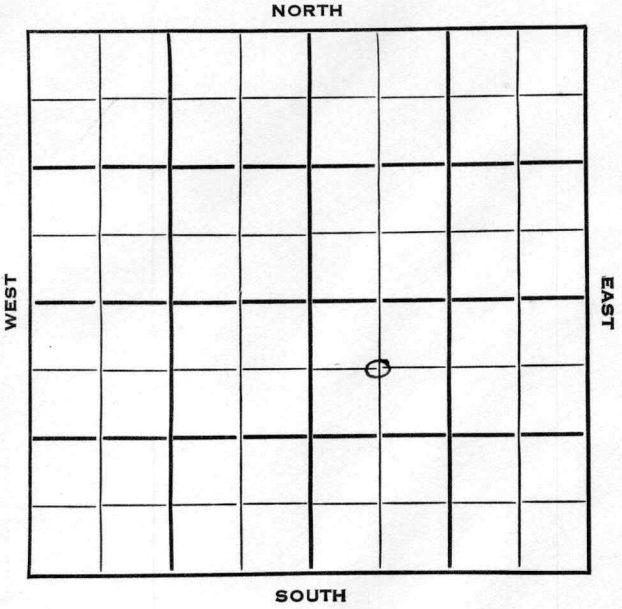

FIRST REPORT

and

COMPLETED

FORM 252-B

Woodson KANSAS ✓

Sec. 35 Twp. 25 R. 15E

Well No. #1 Laidlow Farm

Bert Young Company

Contractor


660 Ft. from N. Line

Ft. from S. Line

Ft. from E. Line

660 Ft. from W. Line

C NW SE

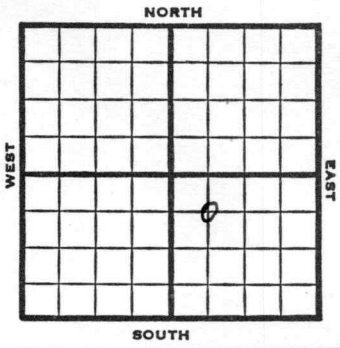

1953	Elev. -	REPORT
1/21	Spud 1-9-53 OilWell TD 1419 8" @ 40 Miss 1396 4" @ 1398 TD 1398 DD1419 FU 150' oil 250A 750A FU free oil Comp. 20 bopd	

FIRST REPORT

COMPLETED

FORM 275 FOR SALE BY KANSAS BLUE PRINT CO.


County Woodson State Kansas

Sec. 35 (Blk. Twp.) 25 (Sur. Rge.) 15E Map No.

Operator Bert Young

Well No. 1 Farm Laidlow

Elev. Location C NW SE

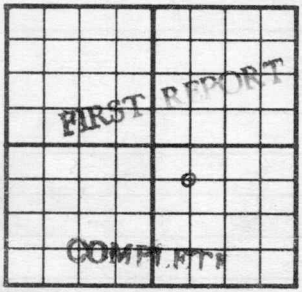

660 Ft. From N Line SE

660 Ft. From W Line Quarter

1st. Report JAN 21 1953

Completion JAN 21 1953

Remarks

Spudding Date 1-9-53

Drlg. Data Oil well TD 1419

8" @ 40 Miss. 1396 4" @ 1398

TD 1398 DD 1419 FU 150' oil 250 A

750 A FU free oil Comp. 20 bopd

J. G. McGEHEE