


KANSAS

Map No. _____ Sec. 16 Twp. 25 R. 16

Well No. 1 Robinson Farm _____

Wood & Attw Company _____

NORTH

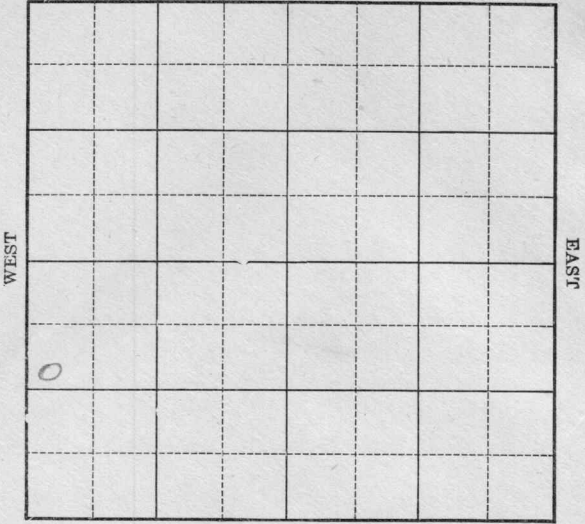

SOUTH

Location _____

Drilling Remarks _____

Rig Up _____

Drilling Remarks _____

RECORD

Cased _____ in. _____ ft.

Sand _____

Gas _____

Oil _____

Total Depth _____

PRODUCTION

1st 24 hrs. Nat. _____

1st 24 hrs. after shot _____

Gas _____ cu. ft.

Dry Hole _____

Abandoned _____

Woodson

Map No. _____ Sec. *16* Twp. *25* R *16*

Well No. *1 Robinson* Farm _____


Wood + Atter Company _____

1120 Ft. from N. Line

_____ Ft. from S. Line

_____ Ft. from E. Line

200 Ft. from W. Line

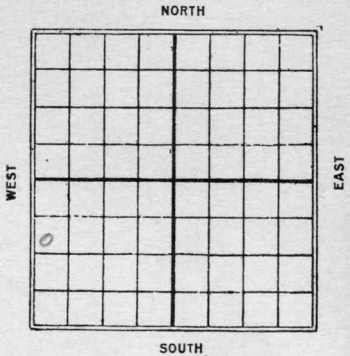

1926

Date

REPORT

1/8

diag @ 300'

1/4

✓ 850'

1/20

1/27

show heavy oil 875'
D & A. T. D. 1286

Woodson Co

no map

Map No. KANSAS Sec. 16 Twp. 25 R. 16

Well No. 1 *Robison*

Wood & HTER Company

Contractor

FIRST REPORTS

SECTION PLAT

1120 Ft. from N. Line

_____ Ft. from S. Line

_____ Ft. from E. Line

200 Ft. from W. Line

Location _____

Rig up _____

Drilling and Remarks:

Depth 300'

RECORD

Cased _____ in., _____ ft.

Sand _____

Gas _____

Oil _____

Total Depth _____

PRODUCTION

1st 24 hrs. Nat. _____

1st 24 hrs. after shot _____

Gas _____ Cu. Ft.

Dry Hole _____

Abandoned _____

Date

JAN 8 1926

CHAS. L. SHERWOOD
Scout

Woodson Co.

Map No. KANSAS Sec. 16 Twp. 25 R. 16

Well No. 1 ROBINSON

Woods & Alter

Company

Contractor

COMPLETED

SECTION PLAT

1120 Ft. from N. Line

----- Ft. from S. Line

----- Ft. from E. Line

300 Ft. from W. Line

ABANDONED

Location -----

Rig up -----

Drilling and Remarks:

Show heavy oil

845

Dry & whd

L.D. 1286'

RECORD

Cased ----- in., ----- ft.

Sand -----

Gas -----

Oil -----

Total Depth 1286'

PRODUCTION

1st 24 hrs. Nat. -----

1st 24 hrs. after shot -----

Gas ----- Cu. Ft.

Dry Hole

Abandoned

Date

JAN 27 1926

192

CHAS. L. SHERWOOD

Scout