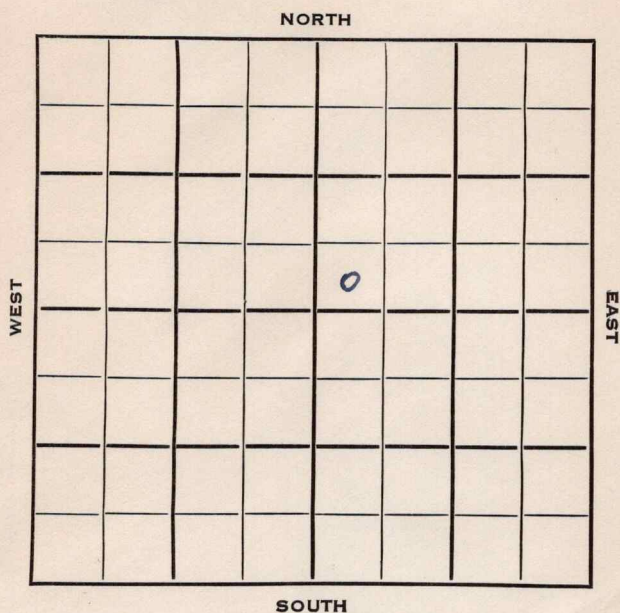


Section 35 Township 20 Range 12WWell No. 4 Batchman "C"Company C R A

Barton

KANONS

SEC.	35	TWP.	20	R.	12W
------	----	------	----	----	-----

WELL NO.

#4 Batchman "C"

FARM

COMPANY

C R A

CONTRACTOR

C R A

Chase-Silica Pool

Ft. from N. Line


330

Ft. from S. Line

Ft. from E. Line

330

Ft. from W. Line

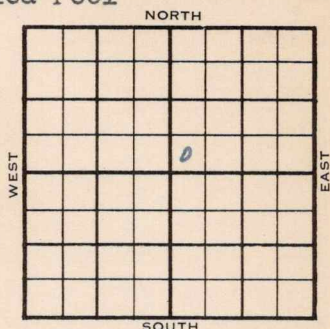

SW SW NE

	ELEVATION	REPORT
1954	1841'	

2/24 Spud 2-19-54
8" @ 267'
Drlg 1920'

3/3 Anhy 640', Heeb 3017', Tor 3033', Br
li 3147', Lans 3161'
DST #X 3288-99', 1/2 hrs., 7' M, Off
Arb. 3408'
DST 3409-14', 1/2 hrs., 22' M, 550#
DST 3409-19', 1 hr., 40' M, Off
DST 3411-35'

3/10 Spud 2-19-54
D&A
TD 3458'
8" @ 267'

Anhy 640', Heeb 3017', Tor 3033', Br.
Lime 3147', Lans 3161'
DST 3288-99', opn 1/2 hrs., rec. 7' mud,
Off
Arb. 3408'
DST 3409-14', opn 1/2 hrs., rec. 32' mud
550#
DST 3409-19', opn 1 hr., rec. 40' mud,
Off
DST 3411-35'
DST 3413-39, opn 1 hr., rec. 90' mud,
200#
TD 3458 - D&A

County **Barton** State **Kansas**

Sec. **35** (Blk. **20** (Sur. **12W** Map No.

Operator **CRA**

Well No. 4 Farm Batchmen "C"

Elev.	Location	SW	SW	NE
-------	----------	----	----	----

0

FIRST REPORT

330 Ft. From S Line NE

330 Ft. From W Line Quarter

1st. Report **FEB 24 1954**

Completion

Remarks

C R A - Contr.

Spudding Date 2-19-54

Drig. Data

Chase-Silica Pool

8" @ 267 drlg. 1920

County Barton State KansasSec. 35 (Blk. 20 (Sur. 12W (Twp.) 12W Map No.Operator C R AWell No. 4 Farm Batchman "C"Elev. 1841 Location SW SW NE330 Ft. From S Line NE330 Ft. From W Line Quarter

1st. Report

Completion MAR 10 1954Remarks Chase-Silica PoolCRA - Contr.Spudding Date 2-19-54Drlg. Data D & A TD 34588" @ 267 Anhy 640 Heeb. 3017Tor. 3033 Br. lime 3147 Lans. 3161DST 3288-99 open $\frac{1}{2}$ hr. Rec. 7' mudO# Arb. 3408 DST 3409-14 open $\frac{1}{2}$ hr.Rec. 32' mud 550# DST 3409-19open 1 hr. Rec. 40' mud O# DST 3411-35 DST 3413-39 open 1 hr. Rec. 90' mud200# TD 3458D & A