


Section 11 Township 31 Range 4E

Well No. #1 Sherwood

Company Roeh Oil & Gas

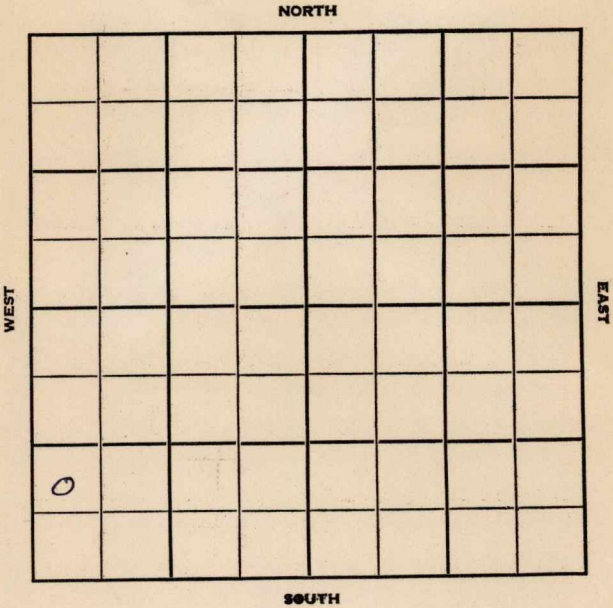

Cowley KANSAS

Sec. 11 Twp. 31 R. 4 E

Well No. # 1 Sherwood Farm

Roth Oil & Gas Company

Watson Contractor


 Ft. from N. Line

990 Ft. from S. Line

 Ft. from E. Line

330 Ft. from W. Line

NW SW SW

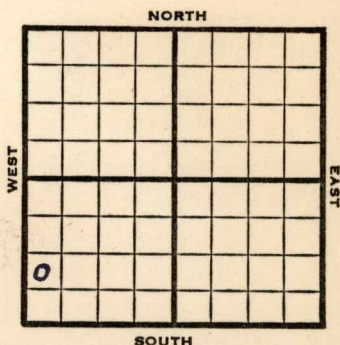

1952 Elev. 1309' REPORT

5/21 Spud 5-15-52
10" @ 100
Drlg. 1670'

6/4 Spud 5-15-52
Oil Well TD 3030' 10" @ 100'
Bart. 3007-25 B. Bart 3025
TD 3030 5" @ 3012' CO to 3024
Hydro. S/ 3 boph Comp. 30 bopd

COMPLETED

Map No. _____ Sec. 11 Twp. 31 R. 4EWell No. 1 Sherwood

Roth Oil & Gas _____ Company

CORRECTION _____ Contractor

NW SW SW

SECTION PLAT

0			

_____ Ft. from N. Line

990 Ft. from S. Line

_____ Ft. from E. Line

330 Ft. from W. Line

Cowley County

Location _____

Rig up _____

Drilling and Remarks:

Reported

Ross Oil & Gas

RECORD

Cased _____ in., _____ ft.

Sand _____

Gas _____

Oil _____

Total Depth _____

PRODUCTION

1st 24 hrs. Nat. _____

1st 24 hrs. after shot _____

Gas _____ Cu. Ft.

Dry Hole _____

Abandoned _____

Date

JUN 4 1952 19J. G. McGEHEE Scout

J. G. McGENEE

