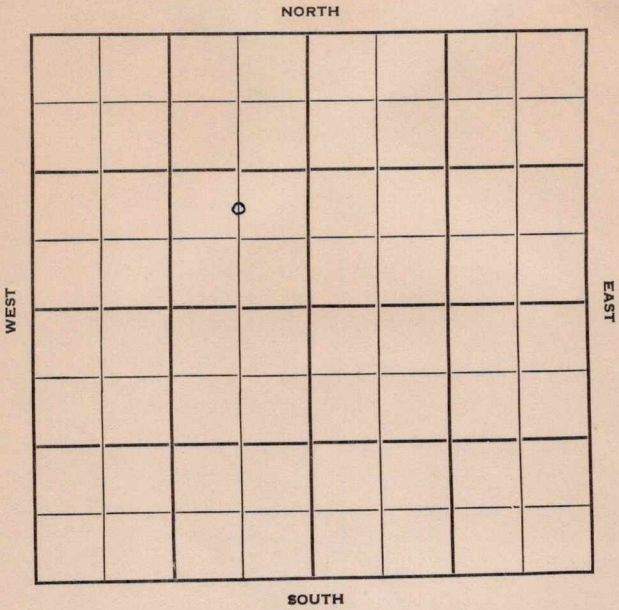


FORM 51 25M 3-49 PETROL

KANSAS

Section 35 Township 20 Range 12-WWell No. #2 KomerckCompany C. S. O.

Barton

KANSAS



Sec. 35 Twp. 20 R. 12W

Well No. #2 Komerck Farm

C. S. O. Company

Contractor

Bryant


 Ft. from N. Line

990' Ft. from S. Line

660' Ft. from E. Line

 Ft. from W. Line

C N/2 SE NW

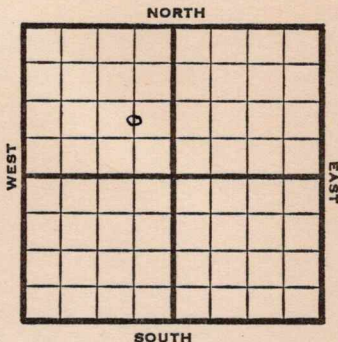

1950 Elev. 1839' REPORT

5/31 Location

7/5 8" @ 251'

Arb. 3401'

5" @ 3404'

DST 3404-07 opn 1/2 hr

Rec. 30' mud

TD 3450'

29' of 4 1/2" liner

PB 3250

31/3193-3201

500 acid

D&A

ABANDONED

Map No. _____ Sec. 35 Twp. 20 R. 12WWell No. 2 Komerik

C. S. O. _____

Company _____

Contractor _____

C N/2 SE NW

SECTION PLAT

	o		
FIRST REPORT			

_____ Ft. from N. Line

990 Ft. from S. Line660 Ft. from E. Line

_____ Ft. from W. Line

Barton

Location X

Rig up _____

Drilling and Remarks:

RECORD

Cased _____ in., _____ ft.

Sand _____

Gas _____

Oil _____

Total Depth _____

PRODUCTION

1st 24 hrs. Nat. _____

1st 24 hrs. after shot _____

Gas _____ Cu. Ft.

Dry Hole _____

Abandoned _____

Date

MAY 31 1950

19

J. E. TYRA

Scout

Kansas

Map No. _____ Sec. 35 Twp. 20 R. 12WWell No. 2 Komerck

_____ Cities Service _____ Company

_____ Contractor


C N L SE NW

El. 1839
SECTION PLAT

_____ Ft. from N. Line

990 Ft. from S. Line660 Ft. from E. Line

_____ Ft. from W. Line

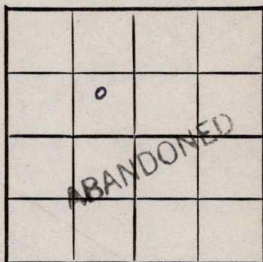

Barton County

Location _____

Rig up _____

Drilling and Remarks:

8" @ 251

Arb. 3401

5" @ 3404

DST 3404-07

open 1 1/2 hr.

Rec. 30' mud

RECORD

Cased _____ in., _____ ft.

Sand _____

Gas _____

Oil _____

Total Depth 3450

PRODUCTION

1st 24 hrs. Nat. _____

1st 24 hrs. after shot _____

Gas _____ Cu. Ft.

Dry Hole _____

Abandoned _____

Date

JUL 5 1950 19J. E. TYRA Scout

TD 3450

29' of 4 $\frac{1}{2}$ " liner

PB 3250.

31/ 3193-3201

500 acid

D & A

Scout Cards
Land Small Map
Land Wall Map
Tracing
France Map
Pierce Map
Misc. Maps

1961

SECTION 16.41

Contractor

Company

MEMO

DATE

BY

TIME

NO.

REMARKS

744956