


Section 35 Township 20 Range 12W

Well No. #1 Lanterman

Company B & B Drlg.

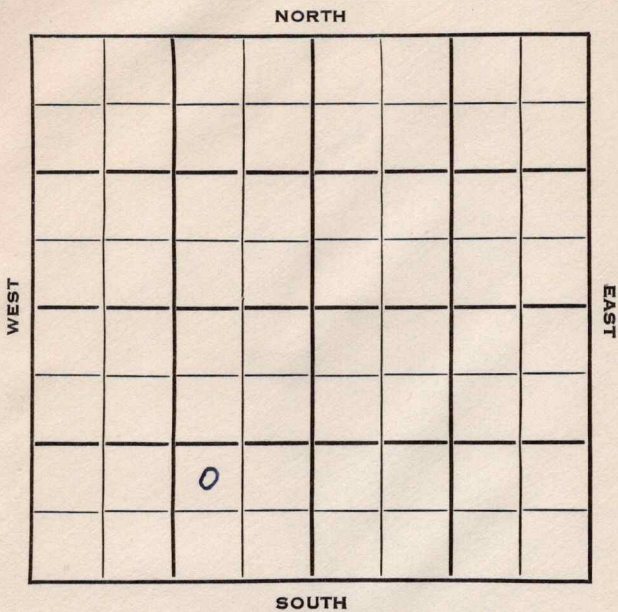

Barton

KANSAS



Sec. 35 Twp. 20 R. 12 W

Well No. # 1 Lanterman Farm

B & B Drlg. Company

B & B Drlg. Contractor


Workman Pool

_____ Ft. from N. Line

990 Ft. from S. Line

990 Ft. from E. Line

_____ Ft. from W. Line

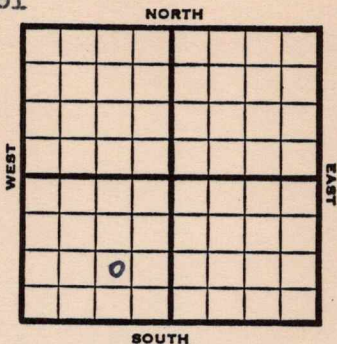

NW SE SW
Kewanee Farmout

1953

Elev. 1846'

REPORT

9/2
9/9

Location
8" @ 244'

9/16

Heeb 3042, Br li 3172, ^uans 3186
DST 3213-55, 1 hr.

9/23

Spud 9-7-53
D & A
TD 3442'
8" @ 244'
Heeb 3042, Br. Lime 3172, Lans 3186,
DST 3213-55 opn $\frac{1}{4}$ hr, rec 10' mud
Arb. 3432
TD 3442'
D & A

ABANDONED

County Barton State Kansas

Sec. 35 (Blk. Twp.) 20 (Sur. Rge.) 12W Map No.

Operator B & B Drlg.

Well No. 1 Farm Lanterman

Elev. 1846 Location NW SE SW

990 Ft. From S Line SW

990 Ft. From E Line Quarter

1st. Report

Completion SEP 23 1953

Remarks Workman Pool

B & B Drlg. - Contr.

Spudding Date 9-7-53

Drlg. Data D & A TD 3442

8" @ 244 Heeb. 3042 Br. lime 3172

Lans. 3186 DST 3213-55 open $\frac{1}{4}$ hr.

Rec. 310' mud Arb. 3432 TD 3442

D & A