


Section 12 Township 31 Range 4E

Well No #2 Cloud

Company McNeish & Gralapp

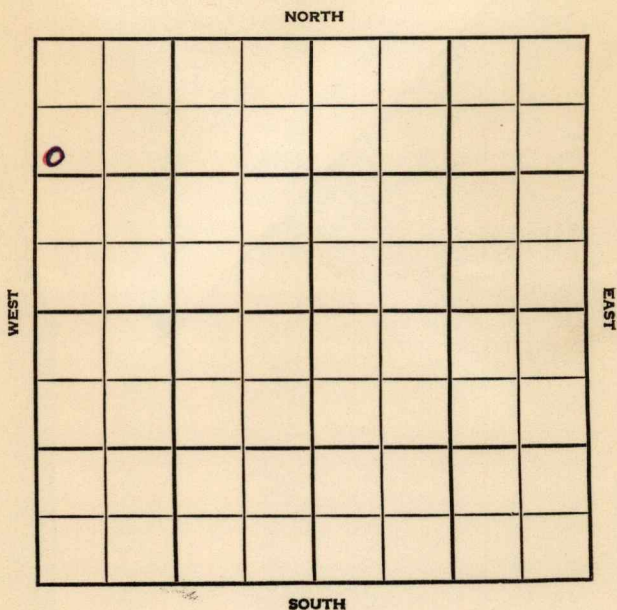

Cowley

KANSAS


SEC.	TWP.	R.
12	31	4 E

WELL NO. # 2 Cloud FARM

COMPANY McNeish & Gralapp

CONTRACTOR Watson David

_____ Ft. from N. Line
 _____ Ft. from S. Line
 _____ Ft. from E. Line
 _____ Ft. from W. Line

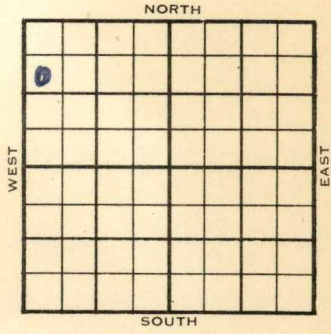

SW NW

1955	ELEVATION	REPORT
------	-----------	--------

6/8

Location

7/7

Comm 6-10-55
 8 5/8" @ 98/100 5 1/2 @ 2936 Coto 2952 frac
 F/100 bopd Comp. 25 bopd.

Tops:	Depth	Log Datum
C. Bart	2929-52	1652
TD	2954	

COMPLETED

County Cowley ✓ Elev. 1277
 Sec. 12 Twp. 31 Rge. 4E
 Company McNeish & Gralapp
 FarmName Cloud No. 2

TOPS	DEPTH	LOG	DATUM	Loc. in Sec.
Anh.				SW NW NW
Tp.				
H.				
Tr.				
Dg.				
Bl.				
L.				Geol.
K.C.				Contr.
B.K.C.				<u>Watson</u>
Ce.				
C.				Pool
M.				<u>David</u>
M.				
K.				
Mz.				
Me.				
V.				
S.				
S.				
A.				
R.				
Pe.				
G.				
T.D.				

0
 FIRST REPORT
 JAN 2 '55

Date Comm. _____
 Location _____

Co.
 Lse.
 No.
 Sec.
 T.
 R.

County Cowley Elev. 1277
 Sec. 12 Twp. 31 Rge. 4E
 Company McNeish & Gralapp
 Farm Name Cloud No. 2

TOPS	DEPTH	LOG	DATUM	Loc. in Sec.
Anh.				SW NW NW
Tp.				
H.				
Tr.				
Dg.				
Bl.				
L.				
K.C.				Geol.
B.K.C.				Contr.
Ce.				
C.	<u>Bart</u>	<u>2929-52</u>	<u>1652</u>	<u>Watson</u>
M.				
M.				Pool
K.				<u>David</u>
Mz.				
Mo.				
V.				
S.				
S.				
A				
R.				
PE.				
G.				
T.D.	<u>2954</u>			



Date Comm. 6-10-55 JUL 6 1955
8 5/8" @ 98/100 5 1/2" @ 2936 CO to 2952
frac F/ 100 bopd Comp. 25 bopd

Co.
Lse.
No.
Sec.
T.
R.