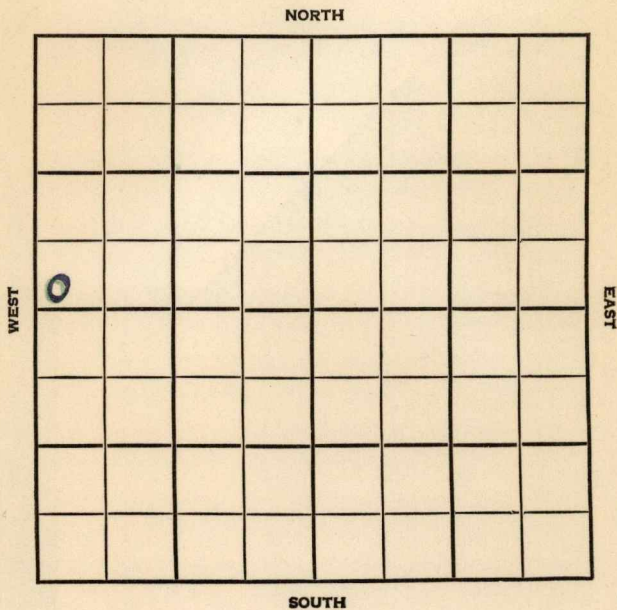


Section 12 Township 31 Range 1EWell No. 4 CloudCompany McNeish & Gralapp

Cowley

KANSAS

SEC.	12	TWP.	31	R.	4E
------	----	------	----	----	----

WELL NO.

4 Cloud

FARM

COMPANY

McNeish & Gralapp

CONTRACTOR

Watson


David

Ft. from N. Line

Ft. from S. Line

Ft. from E. Line

Ft. from W. Line

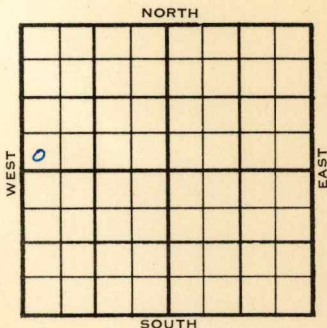

SW SW NW

	ELEVATION	REPORT
1955		
6/29	Comm 6-25-55 8" @ 100/100 Drlg 1540	
7/7	D&A	
	Tops:	Dog. Datum
	Anh. Stal	1944 662
	K. C.	2333- 1051
	BKC Oswego	2725 1443
	M. ch.	2998 1716
	TD	3009
		ABANDONED

[illegible]

County Cowley Elev. 1282Sec. 12 Twp. 31 Rge. 4ECompany McNeish & GralappFarm Name Cloud No. 4

TOPS	DEPTH	LOG	DATUM	Loc. in Sec.
Anh. <u>521</u>		<u>1944</u>	<u>6602</u>	SW SW NW
T.P.				
H.				
Tr.				
Dg.				
BL.				
L.				
K.C.		<u>2333</u>	<u>1051</u>	Geol.
B.K.C. <u>Cowley</u>		<u>2725</u>	<u>1443</u>	Contr.
Ce.				<u>Watson</u>
C.				
M. <u>C.H.</u>		<u>2998</u>	<u>1716</u>	Pool
M.				<u>David</u>
K.				
Mz.				
Mo.				
V.				
S.				
S.				
A.				
R.				
P.C.				
G.				
T.D.	<u>3009</u>			

Date Comm. 6-25-55

JUL 6 1955

8" @ 100/100

D & A

ABANDONED