


Map No. KANSAS Sec. 6 Twp. 26 R. 1E
 Well No. 1- C. G. Branch Farm
Bu- Vi- Bar Company

.....Ft. from N. Line
663 Ft. from S. Line
Ft. from E. Line
1959 Ft. from W. Line

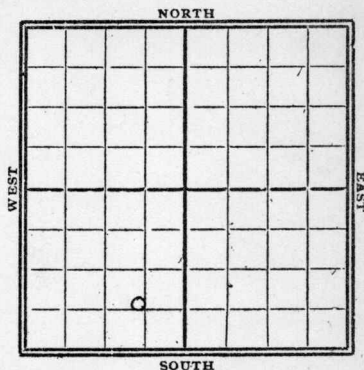

1929

Date	REPORT
1/9	To drill with Rotary Location
1/16	Rig
1/23	Rigged up
1/30	Spud
2/6	drill 1150'
2/13	" 2165'
2/20	" 2950'
2/27	8" at 3325' Std 3g.
3/6	Simpson 3375-81
3/7	flow 1411 bbls.
3/6	flow 835 bbls 12 3/4 hr
3/8	" 988 "
3/11	" 690 "
3/12	" 190 "
	run 3" tubing
3/14	901 bbls.
3/15	Simpson sd. 3375-81'
	T.D. 3381'
	flowed 1411 bbls oil
	Sorp.
	(over)

1929 Production

3/16-	890	bbbl oil - 3 bbls water
3/18-	711	" oil
3/19-	822	" oil - 3 " water
3/21-	812	"
3/22-	806	"
3/23-	776	"
3/25	760	"
3/26-	830	"
3/28-	781	" swab
4/1-	815	"
4/5-	806	"
4/9-	755	"

Georgewick
 Map No. *KANSAS* Sec. *6* Twp. *26* R. *1E*
K13
 Well No. *10 G. Branch*

Bu-Vi-Bar Company

Contractor

SECTION PLAT

Ft. from N. Line

663 Ft. from S. Line

Ft. from E. Line

1959 Ft. from W. Line

FIRST REPORTS

Location *✓*

Rig up

Drilling and Remarks:

*Will drill with
Rotary*

RECORD

Cased *✓* in., *✓* ft.

Sand

Gas

Oil

Total Depth

PRODUCTION

1st 24 hrs. Nat.

1st 24 hrs. after shot

Gas *✓* Cu. Ft.

Dry Hole

Abandoned

Date

JAN 9 - 1929

192

*2640
1957
1880*
S. J. LEWIS

Scout

*Seelgwick*MAP NO. KANSAS SEC. 6 TWP. 26 R. 1EWELL NO. 1 @ G BranchBu-Vi-Bar COMPANY

CONTRACTOR

SECTION PLAT

_____ FT. FROM N. LINE

663 FT. FROM S. LINE

_____ FT. FROM E. LINE

1959 FT. FROM W. LINE

COMPLETED

LOCATION _____

RIG UP _____

DRILLING AND REMARKS:

Simpson Scind
*3375 & 3381**Flowed 1411 Hk*

RECORD

CASED _____ IN. _____ FT.

SAND _____

GAS _____

OIL _____

TOTAL DEPTH 3381

PRODUCTION

1ST 24 HRS. NAT. _____

1ST 24 HRS. AFTER SHOT _____

GAS _____ CU. FT.

DRY HOLE _____

ABANDONED _____

DATE

MAR 13 1929

192

S. J. LEWIS

SCOUT