


DX 78-1 Cowley

Section 12 Township 31 31 Range 4E

Well No. #1 Workman

Company McNeish & Gralapp

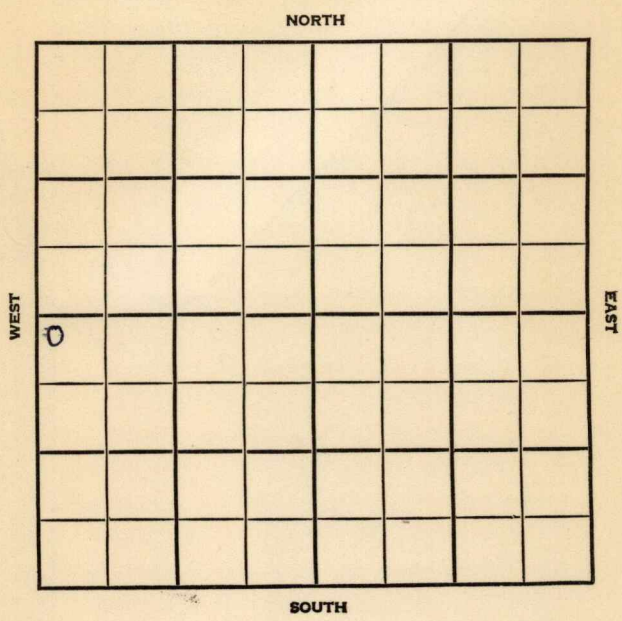

Cowley

KANSAS

SEC.

12

TWP.

31

R.

4E

WELL NO.

1 Workman

FARM

COMPANY

McNeish & Gralapp

CONTRACTOR

Watson


David

Ft. from N. Line

Ft. from S. Line

Ft. from E. Line

Ft. from W. Line

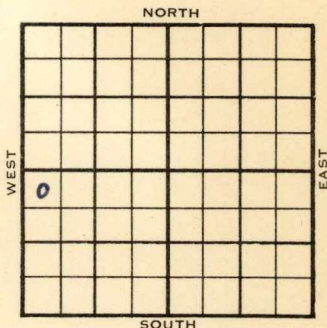

NW NW SW

1955

ELEVATION

REPORT

6/15

Surface Set

6/22

Abd Location

ABANDONED

County Cowley Elev. _____
 Sec. 12 Twp. 31 Rge. 4E
 Company McNeish & Gralapp
 Farm Name Workman No. 1

TOPS	DEPTH	LOG	DATUM
Anh.			
Tp.			
H.			
Tr.			
Dg.			
BL.			
L.			
K.C.			
B.K.C.			
Ce.			
C.			
M.			
M.			
K.			
Mz.			
Me.			
V.			
S.			
S.			
A.			
R.			
Pe.			
G.			
T.D.			

Loc. in Sec. _____

NW NW SW

Geol. _____

Contr. _____

Watson

Pool _____

David

FIRST REPORT

JUN 15 '55

Date Comm. _____

surface set

Co.

Lse.

No.

Sec.

T.

R.

County Cowley Elev. _____
 Sec. 12 Twp. 31 Rge. 4E
 Company McNeish & Gralapp
 Farm Name Workman No. 1

TOPS	DEPTH	LOG	DATUM	Loc. in Sec.
Anh.				NW NW SW
Tp.				
H.				
Tr.				
Dg.				
Bl.				
L.				
K.C.				Geol. _____
B.K.C.				Contr. _____
Ce.				Watson
C.				
M.				
M.				Pool
K.				David
Mz.				
Mq.				
V.				
S.				
S.				
A				
R.				
Pe.				
G.				
T.D.				

JUN 22 1955

Date Comm.

Abd. location