

KANSAS


FORM 51 5M 11-44 PETROL

Cowley County

Section 14 Township 31 Range 4E

Well No. #1 ~~O'Neil~~ Finley "B"

Company Kanotex Ref.

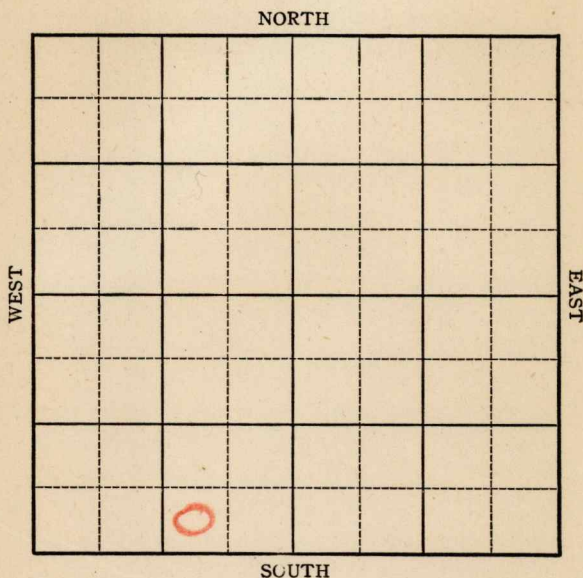

KANSAS

Cowley County

Sec. 14 Twp. 31 R. 4E

Well No. #1 O'Neil Finley "B" Farm

Kanotex Ref. _____ Company


Miscellaneous

_____ Ft. from N. Line

330 _____ Ft. from S. Line

990 _____ Ft. from E. Line

_____ Ft. from W. Line

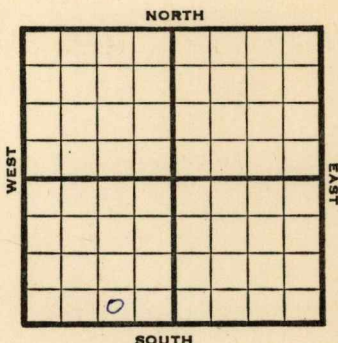

SW SE SW

REPORT

1946

Elev. 1794

1/23

Location

1/31

10" - 80' Drlg. 430'

2/7

Drlg. 2560'

2/13

Miss. 3035'

TD 3037'

ABANDONED


Kansas Pool Name Miscellaneous**KANSAS**Map No. 2 Sec. 14 Twp. 31 R. 4EWell No. 1 O'Neil

Kanotex Ref. _____ Company _____

FIRST REPORT _____ Contractor _____

SW SE SW

SECTION PLAT

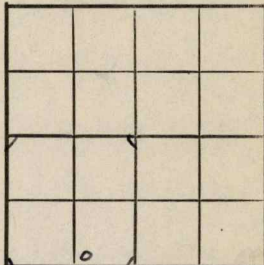

_____ Ft. from N. Line

330 Ft. from S. Line990 Ft. from E. Line

_____ Ft. from W. Line

Cowley County

Location X

Rig up _____

Drilling and Remarks:

RECORD

Cased _____ in., _____ ft.

Sand _____

Gas _____

Oil _____

Total Depth _____

PRODUCTION

1st 24 hrs. Nat. _____

1st 24 hrs. after shot _____

Gas _____ Cu. Ft.

Dry Hole _____

Abandoned _____

Date

JAN 23 1946

19

S. J. LEWIS

Scout

KANSAS

Kansas

Pool Name MiscellaneousMap No. 2 Sec. 14 Twp. 31 R. 4EWell No. 1 Finley "B"

Kantex Ref. _____

Company _____

CORRECTION

Contractor _____

SW SE SW

SECTION PLAT

_____ Ft. from N. Line

330 Ft. from S. Line990 Ft. from E. Line

_____ Ft. from W. Line

Cowley County

Location _____

Rig up _____

Drilling and Remarks:

reported as

#1 O'Neil

RECORD

Cased _____ in., _____ ft.

Sand _____

Gas _____

Oil _____

Total Depth _____

PRODUCTION

1st 24 hrs. Nat. _____

1st 24 hrs. after shot _____

Gas _____ Cu. Ft.

Dry Hole _____

Abandoned _____

Date

FEB 6 1946

19

S. J. LEWIS Scout

Kansas Pool Name Miscellaneous

KANSAS
 Map No. 2 Sec. 14 Twp. 31 R. 4E

Well No. 1 Finley "B"

Kanotex Ref. _____ Company _____

ABANDONED

Contractor _____

SW SE SW

E11794

SECTION PLAT

	0		

_____ Ft. from N. Line

330 Ft. from S. Line990 Ft. from E. Line

_____ Ft. from W. Line

Cowley County

Location _____

Rig up _____

Drilling and Remarks:

Miss 3035

RECORD

Cased _____ in., _____ ft.

Sand _____

Gas _____

Oil _____

Total Depth 3037

PRODUCTION

1st 24 hrs. Nat. _____

1st 24 hrs. after shot _____

Gas _____ Cu. Ft.

Dry Hole _____

Abandoned _____

Date

FEB 1 3 1946 19

S. J. LEWIS

Scout