

Tex Jones et al Company

WEST

EAST

SOUTH

TH 1 1/2 A. track

Rig Up.....

Drilling Remarks

PRODUCTION

1st 24 hrs. Nat.....

1st 24 hrs. after shot.....

Gas.....cu. ft.....

Dry Hole.....

Abandoned.....


Sedgwick
 Map No. KANSAS Sec. 6 Twp. 26 R. 1E
 Well No. 1 - Brown Farm
Tex Jones et al Company

258 Ft. from N. Line

..... Ft. from S. Line

..... Ft. from E. Line

120 Ft. from W. Line

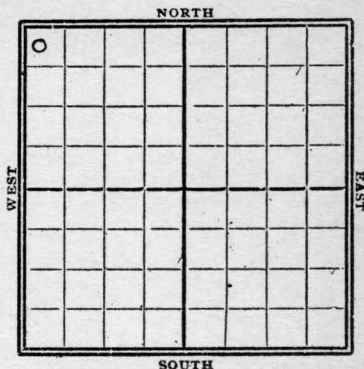

1929

Date	REPORT
1/9	Reg.
1/16	Reg.
1/23	Spud
1/30	
2/16	drlg 1410'
2/13	" 1900'
2/20	" 2015'
2/27	" 2805'
3/6	Top chat 3040'
	drlg 3100'
3/13	" 3275'
3/16	Top Simpson 3413'
	sulphur water
	at 3415' - 1000 ft.
3/20	Drlg 3460'
3/27	" 3550' sdy line
4/3	Simp. sand 3413-15'
	HFV
	T.D. - 3630'
	Dry & Abandoned

Map No. KANSAS Sec. 6 Twp. 25 R. 1E

Well No. 1 Brown

Tex. Jones & Co Company

Contractor

SECTION PLAT

258 Ft. from N. Line

..... Ft. from S. Line

..... Ft. from E. Line

120 Ft. from W. Line

0			

FIRST REPORTS

Location.....

Rig up.....

Drilling and Remarks:

ROG

1 1/2 acre tract

connection attached

RECORD

Cased.....in.,ft.

Sand.....

Gas.....

Oil.....

Total Depth.....

PRODUCTION

1st 24 hrs. Nat.....

1st 24 hrs. after shot.....

Gas.....Cu. Ft.

Dry Hole.....

Abandoned.....

Date

JAN 9 1929

S. J. LEWIS

Scout

*Belgwick*Map No. *KANSAS* Sec. *6* Twp. *26* R. *1E*Well No. *1 Brown**Tex Jones & Co* Company

Contractor

Correction

SECTION PLAT

0			

258 Ft. from N. Line

Ft. from S. Line

Ft. from E. Line

120 Ft. from W. Line

FIRST REPORTS

Location

Rig up

Drilling and Remarks:

*ROG**1 1/2 Acre tract*

RECORD

Cased in, ft.

Sand

Gas

Oil

Total Depth

PRODUCTION

1st 24 hrs. Nat.

1st 24 hrs. after shot

Gas Cu. Ft.

Dry Hole

Abandoned

Date

JAN 9 — 1929

192

S. J. LEWIS

Scout

Map No. 13 KANSAS Sec. 6 Twp. 26 R. 17Well No. 1 BrownH. Jones et al Company

Contractor

SECTION PLAT

0			

258 Ft. from N. Line

Ft. from S. Line

Ft. from E. Line

120 Ft. from W. Line

ABANDONED

Location

Rig up

Drilling and Remarks:

Simpson Sand
3413 - 15 HFWDAH

RECORD

Cased.....in.,ft.

Sand.....

Gas.....

Oil.....

Total Depth 3690

PRODUCTION

1st 24 hrs. Nat.....

1st 24 hrs. after shot.....

Gas.....Cu. Ft.

Dry Hole.....

Abandoned.....

Date

APR 3 1929 S. J. LEWIS Scout

192