



Sedgwick

Form 252-A  
5M 4-32 MPC

Map No. KANSAS Sec. 6 Twp 26 R. 1E

Well No. 1-Burk Farm


United Pet Company

         Ft. from N. Line

840 Ft. from S. Line

1000 Ft. from E. Line

         Ft. from W. Line

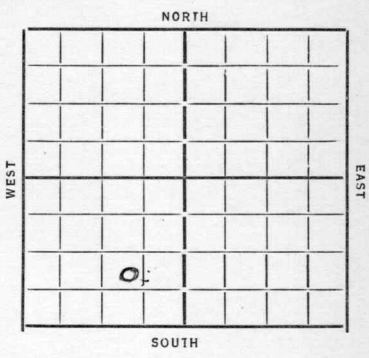

Date  
1934

REPORT

1/17 Spudding 600  
1/22 wreg 1000  
1/31 " 1810  
2/7 " 2415  
2/17 K.C.L. 2550 Run 5" 2552  
2/23 2585 1000' fluid  
3/1 1200 Gal acid Pump 3  
 oil 150 water 24 hrs.  
3/7 K.C.L. 2550 YD 2695  
 P. & H.

ABANDONED

Map No. 13 Sec. 6 Twp. 26 R. 1E

Well No. 1-Bunk

United pt. Company

Contractor

FIRST REPORTS

SECTION PLAT

.....Ft. from N. Line

840 Ft. from S. Line

1000 Ft. from E. Line

.....Ft. from W. Line

	0		

Location.....

Rig up.....

Drilling and Remarks:

12" 41

Spudding 600

RECORD

Cased.....in., .....ft.

Sand.....

Gas.....

Oil.....

Total Depth.....

PRODUCTION

1st 24 hrs. Nat.....

1st 24 hrs. after shot.....

Gas.....Cu. Ft.

Dry Hole.....

Abandoned.....

Date

1-17-34 192 O. Mammesbruch Scout

Map No. 13 Sec. 6 Twp. 26 R. 1E

Well No. 1-Buck

United pet Company

Contractor

SECTION PLAT

Ft. from N. Line

840 Ft. from S. Line

1000 Ft. from E. Line

Ft. from W. Line

	0		

ABANDONED

Location.....

Rig up.....

Drilling and Remarks:

*Dry + abd*

RECORD

Cased        in.,        ft.

Sand KEL 2550

Gas.....

Oil.....

Total Depth 2695

PRODUCTION

1st 24 hrs. Nat.....

1st 24 hrs. after shot.....

Gas..... Cu. Ft.

Dry Hole.....

Abandoned.....

Date

3-7-34 192 O. Mannschreck Scout