


*Sedgwick*

Form 51-5M-2-29-34703

Map No. **KANSAS** Sec. *6* Twp. *26* R. *1E*

Well No. *3-A* *Bright* Farm  
*Bu-Vi-Balch* Company

NORTH

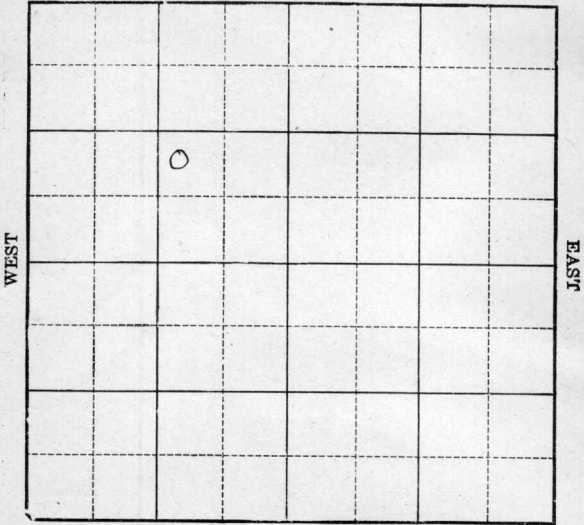

SOUTH

Location \_\_\_\_\_

Drilling Remarks \_\_\_\_\_

Rig Up \_\_\_\_\_

Drilling Remarks \_\_\_\_\_

**RECORD**

Cased \_\_\_\_\_ in. \_\_\_\_\_ ft.

Sand \_\_\_\_\_

Gas \_\_\_\_\_

Oil \_\_\_\_\_

Total Depth \_\_\_\_\_

**PRODUCTION**

1st 24 hrs. Nat. \_\_\_\_\_

1st 24 hrs. after shot \_\_\_\_\_

Gas \_\_\_\_\_ cu. ft.

Dry Hole \_\_\_\_\_

Abandoned \_\_\_\_\_

Sedgwick

FORM 252A-5M-12-28-PETROL

Map No. KANSAS Sec. 6 Twp. 26R 1E

Well No. 3-A Bright Farm


Bu-Vi-Bar et al Company

\_\_\_\_\_ Ft. from N. Line

1050 Ft. from S. Line

1155 Ft. from E. Line

\_\_\_\_\_ Ft. from W. Line

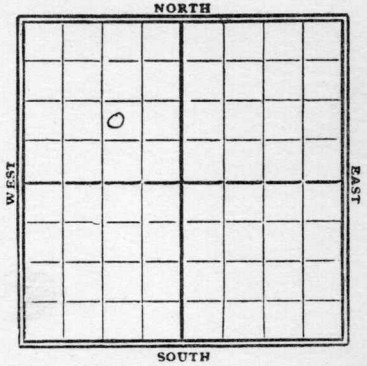

1929

Date	REPORT
3/13	Pellur (Rotary)
3/20	—
3/27	—
4/3	—
4/10	—
4/17	—
4/24	—
5/1	—
5/8	—
5/15	—
5/22	—
5/29	—
6/15	Abandon location

*Seigwick*  
Map No. *13* **KANSAS** Sec. *6* Twp. *26* R. *1E*  
Well No. *3. F. Bright*

*Bu-Vi Boy et al* Company  
Contractor

SECTION PLAT


.....Ft. from N. Line  
*1050* Ft. from S. Line  
*1155* Ft. from E. Line  
.....Ft. from W. Line

FIRST REPORTS

Location.....  
Rig up.....  
Drilling and Remarks:

*Rotary*  
*Oil*

RECORD

Cased.....in., .....ft.  
Sand.....  
Gas.....  
Oil.....  
Total Depth.....

PRODUCTION

1st 24 hrs. Nat.....  
1st 24 hrs. after shot.....  
Gas.....Cu. Ft.  
Dry Hole.....  
Abandoned.....

Date

MAR 18 1929

192.....

*S. I. LEWIS* Scout

Map No. *13* **KANSAS** Sec. *6* Twp. *26* R. *1E*

Well No. *2 A Bright*

*Burke & Burdett* Company

Contractor

SECTION PLAT

..... Ft. from N. Line

*1050* Ft. from S. Line

*1155* Ft. from E. Line

..... Ft. from W. Line

	o		

ABANDONED

Location.....

Rig up.....

Drilling and Remarks:

*Cellar  
D & H*

RECORD

Cased..... in., ..... ft.

Sand.....

Gas.....

Oil.....

Total Depth.....

PRODUCTION

1st 24 hrs. Nat.....

1st 24 hrs. after shot.....

Gas..... Cu. Ft.

Dry Hole.....

Abandoned *Loc*

Date

JUN 5 1929

192.....

S. J. LEWIS Scout