

KANSAS

Cowley

FORM 51 5M 10-41 PETROL

Section 13 Township 31 Range 4-E

Well No. #1 H. A. Miller

Company Arthur Brewer

NORTH Deichman Pool

WEST

EAST

	0						

SOUTH

Sec. 13 Twp. 31 R. 4-E

Well No. #1 H. A. Miller Farm

Arthur Brewer Company

(Deichman)


 Ft. from N. Line

330 Ft. from S. Line

 Ft. from E. Line

990 Ft. from W. Line

Elev. 1221

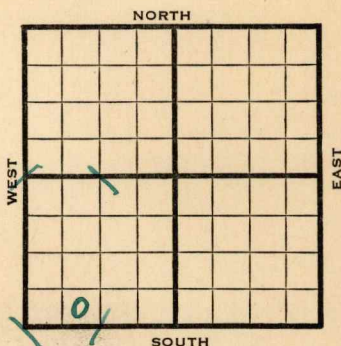

1942

REPORT

7/8 Cellar.

7/15 Machine.

7/22 15" - 325' 1087 Run 12"

7/29 12" - 1087 Drlg. 1525'

8/5 Drlg. 1650'

8/12 KC 2285 Drlg 2325

8/19 10" - 1665 8" - 2081

Drlg. 2605'

8/27 6" - 2620

Bart. 2833

Miss. 2932

No shows

T.D. 2962'

ABANDONED

Cowley

KANSAS

Map No. 2 Sec. 13 Twp. 31 R. 4EWell No. 1 H. A. Miller

Arthur Brewer


Company

FIRST REPORT

Contractor

SE SW SW

SECTION PLAT

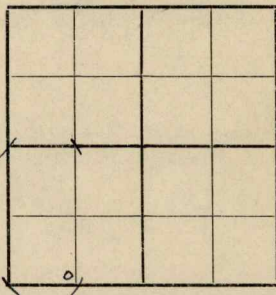 Ft. from N. Line330 Ft. from S. Line Ft. from E. Line990 Ft. from W. Line

DEICHMAN POOL

Location Rig up

Drilling and Remarks:

Cellar

RECORD

Cased in., ft.Sand Gas Oil Total Depth

PRODUCTION

1st 24 hrs. Nat. 1st 24 hrs. after shot Gas Cu. Ft.Dry Hole Abandoned

Date

JUL 8 1942 19S. J. LEWIS Scout

Cowley

KANSAS

Map No. 2 Sec. 13 Twp. 31 R. 4EWell No. 1 H. A. Miller

Arthur Brewer

Company

ABANDONED

Contractor

SE SW SW

SECTION PLAT

Ft. from N. Line

330

Ft. from S. Line

Ft. from E. Line

990

Ft. from W. Line

DEICHMAN POOL

Location _____

Rig up _____

Drilling and Remarks:

6" @ 2620Bar 2833Miss 2932Noe howe

RECORD

Cased _____ in., _____ ft.

Sand _____

Gas _____

Oil _____

Total Depth 2962

PRODUCTION

1st 24 hrs. Nat. _____

1st 24 hrs. after shot _____

Gas _____ Cu. Ft.

Dry Hole _____

Abandoned _____

Date

AUG 27 1942

19

S. J. LEWIS Scout