


Sedgwick
 Map No. KANSAS Sec. 6 Twp. 26 R. 1E
 Well No. 4-"B" Bright Farm
Bu-Vi-Bar Company

_____ Ft. from N. Line
403 Ft. from S. Line
 _____ Ft. from E. Line
780 Ft. from W. Line

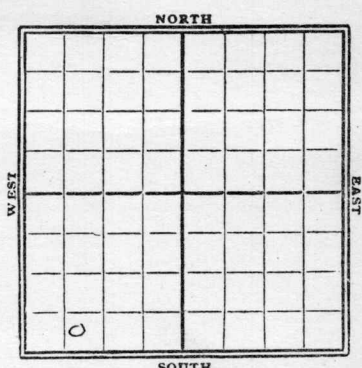

1929

Date

REPORT

5/1	Bldg Reg
5/8	Spud
5/15	here 91080'
5/22	" 2170'
5/29	" 2843'
6/5	8" - 3310'
6/12	Dempson 3365-67'
	No test
6/19	Dempson 3365-75'
	T.D. 3375'
	swab 484 bbls oil
	5 on p.

Map No. KANSAS Sec. 6 Twp. 26 R. 1E

Well No. 4 B. Bright

Bu Vi. Balf et al. Company

Contractor

SECTION PLAT

Ft. from N. Line

403 Ft. from S. Line

Ft. from E. Line

280 Ft. from W. Line

FIRST REPORTS

Location

Rig up

Drilling and Remarks:

Building rig

RECORD

Cased in., ft.

Sand

Gas

Oil

Total Depth

PRODUCTION

1st 24 hrs. Nat.

1st 24 hrs. after shot

Gas Cu. Ft.

Dry Hole

Abandoned

Date

MAY 1 1929

192

S. J. LEWIS

Scout

Map No. KANSAS Sec. 6 Twp. 26 R. 1E

Well No. 4 B. Bright

Bu Vi Gas & Oil Company

Contractor

SECTION PLAT

Ft. from N. Line

403 Ft. from S. Line

Ft. from E. Line

780 Ft. from W. Line

COMPLETED

Location

Rig up

Drilling and Remarks:

Simpson 3365-
3375

Swart 484886

RECORD

Cased.....in.,ft.

Sand.....

Gas.....

Oil.....

Total Depth 3375

PRODUCTION

1st 24 hrs. Nat.....

1st 24 hrs. after shot.....

Gas.....Cu. Ft.

Dry Hole.....

Abandoned.....

Date

JUN 19 1929

S. J. LEWIS Scout