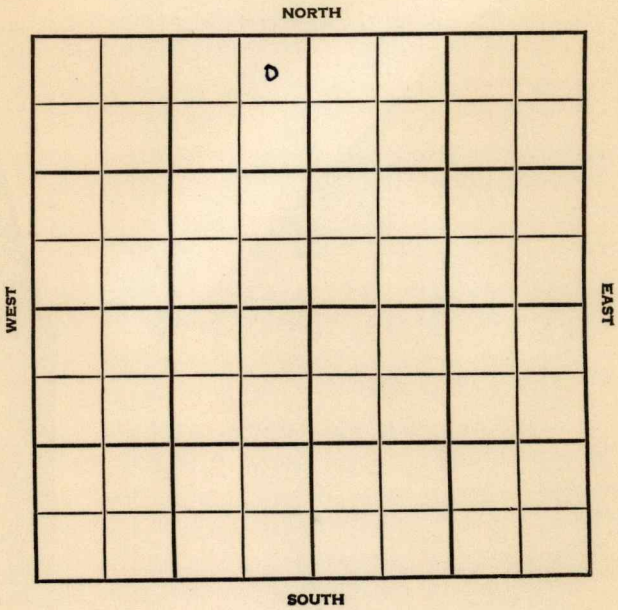


Section 15 Township 31 Range 1EWell No. #2 DunbarCompany Aladdin Pet.

SEC.	15	TWP.	31	R.	4E
------	----	------	----	----	----

WELL NO.	2 Dunbar	FARM
----------	----------	------

COMPANY	Aladdin Pet.
---------	--------------


CONTRACTOR	Tri- State N. Hittle Pool
------------	------------------------------

330 Ft. from N. Line

Ft. from S. Line

330 Ft. from E. Line

Ft. from W. Line

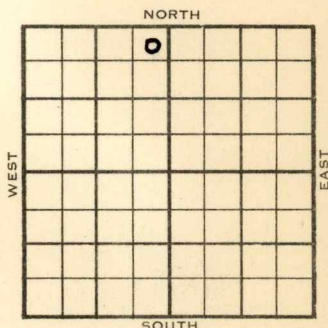

NE NE NW

1954	ELEVATION	REPORT
------	-----------	--------

8/11 Spdg 8-7-54
8" @ 105
Drlg. 514

9/15 Spud 8-7-54
Oil Well
TD 2979'
8" @ 105'
KC 2360', Marm 2670', Cherokee 2784'
Bart. 2955'
TD 2979'
5" @ 2956'
CO to 2979'
sd-frac. P/ 30 bopd.
Comp. 25 bopd.

COMPLETED

County Cowley State KansasSec. 15 (Blk.) 31 (Sur.) 4E Map No.Operator Aladdin Pet.Well No. 2 Farm DunbarElev. Location NE NE NW

330 Ft. From N Line NW330 Ft. From E Line Quarter1st. Report AUG 11 1954

Completion

Remarks

Tri-State - Contr.Spudding Date 8-7-54Drlg. Data N. Hittle Pool8" @ 105 drlg. 514

FABEN GILSTRAP