

Sedgwick

Map No. KANSAS Sec. 6 Twp. 26 R. 1^E


Well No. 2 - Caldwell Farm
Pyke & Tuttle Company

_____ Ft. from N. Line

1190 Ft. from S. Line

_____ Ft. from E. Line

1840 Ft. from W. Line

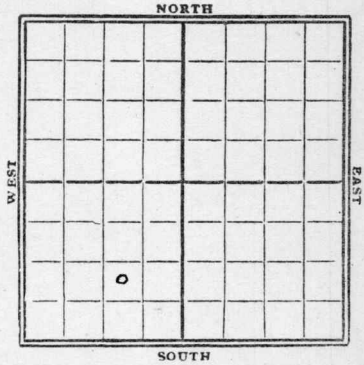

1929

Date

REPORT

Date	REPORT
1/16	Bldy Rig
1/23	Rough up
1/30	Spud
2/16	drly 760'
2/13	" 1315'
2/20	" 1365'
2/27	" 1790'
3/6	" 2375'
3/13	" 2555'
3/20	" 2730'
3/27	" 3110'
4/3	" 3320'
4/19	Top sand 3383-84' swab 1045 bbl 24 hr.
4/10	Comp. sd 3383-84' T.D. 3384' swab 1045 bbl oil Comp.

Sealgwick

MAP NO. KANSAS SEC. 6 TWP. 26 R. 15

113
WELL NO. 2 Caldwell

Pyke & Sutter COMPANY
CONTRACTOR

SECTION PLAT

_____ FT. FROM N. LINE

1190 FT. FROM S. LINE

_____ FT. FROM E. LINE

1840 FT. FROM W. LINE

First Report

LOCATION _____

RIG UP _____

DRILLING AND REMARKS:

Building rig

RECORD

CASED _____ IN., _____ FT.

SAND _____

GAS _____

OIL _____

TOTAL DEPTH _____

PRODUCTION

1ST 24 HRS. NAT. _____

1ST 24 HRS. AFTER SHOT _____

GAS _____ CU. FT.

DRY HOLE _____

ABANDONED _____

DATE

JAN 16 1929 192

S. J. LEWIS SCOUT

Map No. *13* **KANSAS** Sec. *6* Twp. *26* R. *1E*

Well No. *2 Caldwell*

Pyle & Satter Company

Contractor

SECTION PLAT

	0		

.....Ft. from N. Line

1190 Ft. from S. Line

.....Ft. from E. Line

1840 Ft. from W. Line

COMPLETED

RECORD

Location.....

Cased.....in.,ft.

Rig up.....

Sand.....

Drilling and Remarks:

Gas.....

Simpson Sand

Oil.....

3383 & 3384

Total Depth *3384*

Swatting 10458

PRODUCTION

1st 24 hrs. Nat.....

1st 24 hrs. after shot.....

Gas.....Cu. Ft.

Dry Hole.....

Abandoned.....

Date

APR 10 1929

S. J. LEWIS

192.....

Scout

Seagricks

13 **KANSAS** Map No. _____ Sec. 6 Twp. 76 R. 1 ^E

Well No. 2 Caldwell

Pyle & Sutter Company

Contractor

SECTION PLAT

	o		

_____ Ft. from N. Line

1190 Ft. from S. Line

_____ Ft. from E. Line

1840 Ft. from W. Line

ABANDONED

Location _____

Rig up _____

Drilling and Remarks:

Plugged
6/26/30

RECORD

Cased _____ in., _____ ft.

Sand _____

Gas _____

Oil _____

Total Depth 3384

PRODUCTION

1st 24 hrs. Nat. _____

1st 24 hrs. after shot _____

Gas _____ Cu. Ft.

Dry Hole _____

Abandoned _____

Date

JAN 30 1932

CHAS. L. SHERWOOD