


Map No. KANSAS Sec. 6 Twp. 26 R. 1^E

Well No. 1 - Emerich Farm
Bu - Vi - Bar Company

.....Ft. from N. Line
663 Ft. from S. Line
Ft. from E. Line
1345 Ft. from W. Line

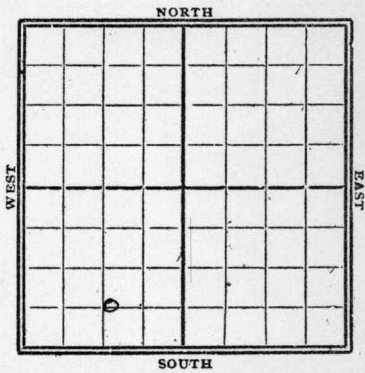

1929

Date	REPORT
1/9	Rog. (Rotary)
1/16	Rig
1/23	Rig up
1/30	Spud
2/6	drlg 1760'
2/13	" 2585'
2/20	Top line 3040'
2/21	Pen 8" - 3320'
2/27	drlg out cement
3/5	TD. 3428' T.P. 3428'
	made 146 bbls oil
3/7	swab 1310 " "
	from Pump. 3428-33'
3/7	Swabbing 1096' bbls.
3/11	made 1400 bbls oil
3/12	swab 1164 " "
3/14	798 bbls.
3/15	Simpson 3428-33'
	TD. 3433'
	Swabbed 1310 bbls.
	Pump.
	(over)

1929 Production

3/16 - 1215 bbls.

3/18 - 1108 "

3/19 - 1088 "

3/21 - 1093 "

3/22 - 729 "

3/23 - 812 "

3/23 822 "

3/26 343 "

3/28 - 672 " swab

4/1 - 642 "

4/15 - 474 "

4/19 - 516 "

Sedgwick

Map No. KANSAS Sec. 6 Twp. 26 R. 15

Well No. 1 Emeric

Bu-Vi-Bar Company

Contractor

SECTION PLAT

	0		

..... Ft. from N. Line

667 Ft. from S. Line

..... Ft. from E. Line

1245 Ft. from W. Line

FIRST REPORTS

Location.....

Rig up.....

Drilling and Remarks:

ROY
will drill with
Rotary

RECORD

Cased.....in.,ft.
Sand.....
Gas.....
Oil.....
Total Depth.....

PRODUCTION

1st 24 hrs. Nat.....
1st 24 hrs. after shot.....
Gas.....Cu. Ft.
Dry Hole.....
Abandoned.....

Date

JAN 9 - 1929

S. J. LEWIS

Scout

Beolgwick

MAP NO. KANSAS SEC. 6 TWP. 26 R. 1E

WELL NO. 13 Emerick

Bu-Vi Bar COMPANY

CONTRACTOR

SECTION PLAT

_____ FT. FROM N. LINE

663 FT. FROM S. LINE

_____ FT. FROM E. LINE

1345 FT. FROM W. LINE

COMPLETED

LOCATION _____

RIG UP _____

DRILLING AND REMARKS:

*Simpson sand
3428 to 3433*

*Swatford
1310 ft*

RECORD

CASED _____ IN. _____ FT.

SAND _____

GAS _____

OIL _____

TOTAL DEPTH 3433

PRODUCTION

1ST 24 HRS. NAT. _____

1ST 24 HRS. AFTER SHOT _____

GAS _____ CU. FT.

DRY HOLE _____

ABANDONED _____

DATE

MAR 13 1929

192

S. J. LEWIS SCOUT