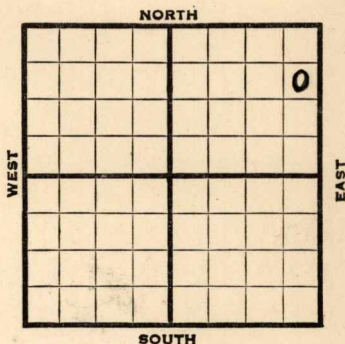


KANSAS

Cowley

Sec. 15 Twp. 31 R. 4-EWell No. #2 Gretsinger FarmRoth Oil & Gas Company

(Miscellaneous)

990 Ft. from N. Line Ft. from S. Line330 Ft. from E. Line Ft. from W. Line**Elev. 1288**

1938	REPORT
12/21	Location
12/30	"
1939	
1/6	Spud.
1/13	15" - 494'. Drlg. 495'.
1/20	12" - 975'. Drlg. 1250'.
1/27	Drlg. 1575'.
2/3	10" - 1618'. Drlg. 1825'.
2/10	8" - 1846'. Drlg. 2142'.
2/17	8" - 2227'. Drlg. 2435'.
2/23	Drlg. 2620'
3/3	K. C. 2425' T. D. 2960'
	6" - 2958' b C. O.
3/10	6" - 2983' Bart. 2999'
	T.D. 3018' 200' oil 12 hrs.
3/17	" " " " " "
3/24	SD 3018'
3/31	" "
4/7	" "
4/14	" "
4/21	" "

OVER

Cowley **KANSAS**Map No. 2 Sec. 15 Twp. 31 R. 4EWell No. 2 GretsingerRoth Oil & Gas

Company

Contractor

FIRST REPORT**SE NE NE**990 Ft. from N. Line Ft. from S. Line330 Ft. from E. Line Ft. from W. Line**SECTION PLAT**

			0

MISCELLANEOUSLocation ✓Rig up

Drilling and Remarks:

RECORDCased in., ft.Sand Gas Oil Total Depth **PRODUCTION**1st 24 hrs. Nat. 1st 24 hrs. after shot Gas Cu. Ft.Dry Hole Abandoned

Date

DEC 21 1938 19H. D. Hatfield

Scout

Map No. _____ Sec. 15 Twp. 31 R. 4EWell No. 2 GretsingerRoth Oil & Gas

Company _____

Contractor _____

ABANDONED

SE NENE

990 Ft. from N. Line

_____ Ft. from S. Line

330 Ft. from E. Line

_____ Ft. from W. Line

MISCELLANEOUS

SECTION PLAT

Location _____

Rig up _____

Drilling and Remarks:

*Bar 82999**Shot 609 to 2997 -
3016.**Pump 1 1/2 x 4 1/2 per day*

RECORD

Cased _____ in., _____ ft.

Sand _____

Gas _____

Oil _____

Total Depth 3018

PRODUCTION

1st 24 hrs. Nat. _____

1st 24 hrs. after shot _____

Gas _____ Cu. Ft.

Dry Hole _____

Abandoned _____

Date

MAY 31 1939

19

S. J. LEWIS

Scout