

KANSAS

Cowley

Form 51—5M—7-40—Palace

Section 15 Township 31 Range 4-E

Well No. #4 Gretsinger


Company Roth Oil & Gas

Miscellaneous

NORTH

WEST

EAST

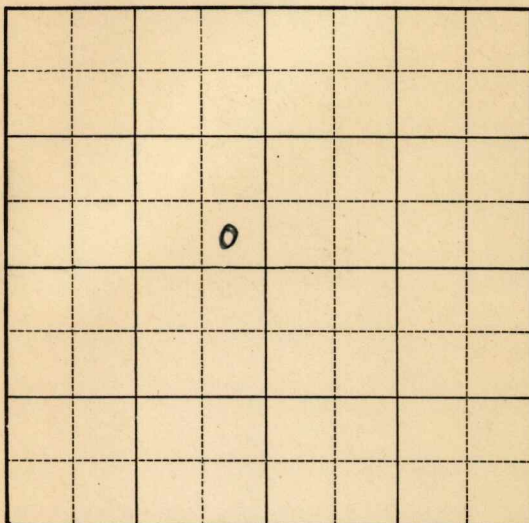

SOUTH


KANSAS

Cowley

Sec. 15 Twp. 31 R. 4-EWell No. #4 Gretsinger FarmRoth Oil & Gas

Company

(Misc.)

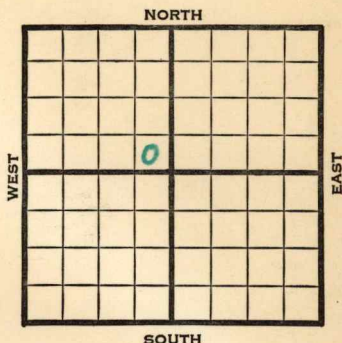 Ft. from N. Line330 Ft. from S. Line330 Ft. from E. Line Ft. from W. Line

Elev. 1274.

1941	REPORT
3/12	Machine - Spud.
3/20	SD 25'
3/27	"
4/3	"
4/10	"
4/18	"
4/24	"
5/1	"
5/8	"
5/15	S.O. 448'
	Drlg. 460'
5/22	Drlg. 475'
5/28	SD 477'
6/5	"
6/12	"
6/19	"
6/26	15" - 469' C.O.
7/3	Drlg. 605'
7/10	Drlg. 680'
7/17	SD 780'

OVER

1041

	780'	Shut	down
7/24	"	"	"
7/31	"	"	"
8/7	"	"	"
8/15	"	"	"
8/21	"	"	"
8/28	"	"	"
9/4	"	"	"
9/11	"	"	"
9/18	"	"	"
9/25	"	"	"
10/2	"	"	"
10/9	"	"	"
10/16	"	"	"
10/23	"	"	"
10/30	"	"	"

11/5 T.D. 780'

ABANDONED

Map No. 2 Sec. 15 Twp. 31 R. 4EWell No. 4 GretsingerRoth Oil & Gas CompanyFIRST REPORT Contractor

SE NW

 Ft. from N. Line330 Ft. from S. Line330 Ft. from E. Line Ft. from W. Line

Miscellaneous

SECTION PLAT

Location Rig up

Drilling and Remarks:

Machine

Spud

RECORD

Cased in., ft.Sand Gas Oil Total Depth

PRODUCTION

1st 24 hrs. Nat. 1st 24 hrs. after shot Gas Cu. Ft.Dry Hole Abandoned

Date

MAR 12 1941 19

S. J. LEWIS Scout

Map No. K-2 Sec. 15 Twp. 31 R. 4EWell No. 4 GretsingerRoth Oil & Gas CompanyABANDONED Contractor

SE NW

SECTION PLAT

		6	

 Ft. from N. Line330 Ft. from S. Line330 Ft. from E. Line Ft. from W. Line

MISCELLANEOUS

Location Rig up Drilling and Remarks:

RECORD

Cased in., ft.Sand Gas Oil Total Depth 280

PRODUCTION

1st 24 hrs. Nat. 1st 24 hrs. after shot Gas Cu. Ft.Dry Hole Abandoned

Date

NOV 5 1941 19 S. J. LEWIS Scout