

Sedgwick


Form 51-5M-2-29-34703

Map No. KANSAS Sec. 6 Twp. 26 R. 1E

Well No. 6 - Tad Goodrich Farm

Bru-Vi-Barthal Company

NORTH

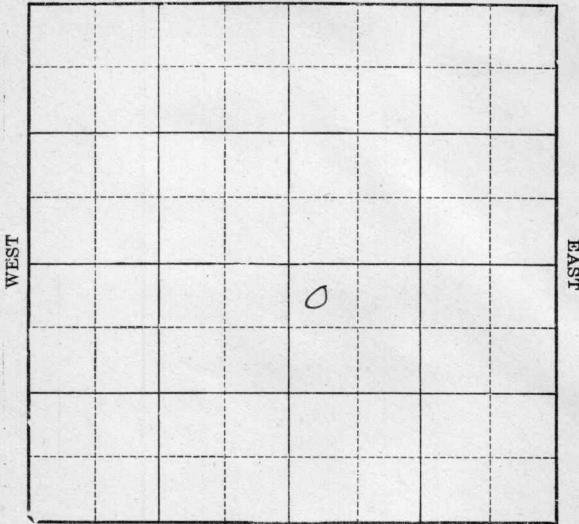

SOUTH

Location \_\_\_\_\_

Drilling Remarks \_\_\_\_\_

Rig Up \_\_\_\_\_

Drilling Remarks \_\_\_\_\_

RECORD

Cased \_\_\_\_\_ in. \_\_\_\_\_ ft.

Sand \_\_\_\_\_

Gas \_\_\_\_\_

Oil \_\_\_\_\_

Total Depth \_\_\_\_\_

PRODUCTION

1st 24 hrs. Nat. \_\_\_\_\_

1st 24 hrs. after shot \_\_\_\_\_


Gas \_\_\_\_\_ cu. ft.

Dry Hole \_\_\_\_\_

Abandoned \_\_\_\_\_

*Sedgwick*  
 Map No. KANSAS Sec. 6 Twp. 26 R. 1E  
 Well No. 6 - Tad Goodrich Farm  
Bu-Vi-Bal et al Company

330 Ft. from N. Line  
 \_\_\_\_\_ Ft. from S. Line  
 \_\_\_\_\_ Ft. from E. Line  
393 Ft. from W. Line

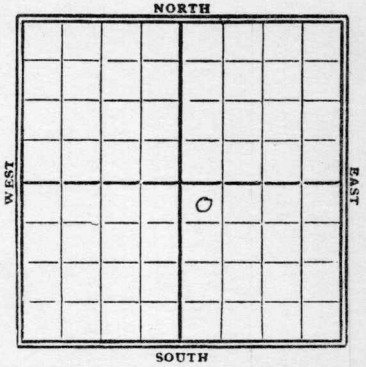

1929

Date

REPORT

4/3	Rig
4/10	Wrlg 180'
4/17	" 1430'
4/24	" 2380'
5/11	" 3310'
5/18	8" - 3325'
5/15	Simpson 3378-82 T.D. 3382 swab 25 bbls oil Pump.

*Goodrich*  
KANSAS

Map No. *13* Sec. *6* Twp. *26* R. *14*

Well No. *6* *Tad Goodrich*

*Bur-Vi Bur et al* Company

Contractor

SECTION PLAT

*220* Ft. from N. Line

..... Ft. from S. Line

..... Ft. from E. Line

*393* Ft. from W. Line

		0	

FIRST REPORTS

Location.....

Rig up.....

Drilling and Remarks:

*Rig*

RECORD

Cased.....in., .....ft.

Sand.....

Gas.....

Oil.....

Total Depth.....

PRODUCTION

1st 24 hrs. Nat.....

1st 24 hrs. after shot.....

Gas.....Cu. Ft.

Dry Hole.....

Abandoned.....

Date

APR 3 1929

S. J. LEWIS

Scout

Map No. *13* **KANSAS** Sec. *6* Twp. *26* R. *1E*

Well No. *6* *Paul Goodrich*

*Burke & Co* Company

Contractor

SECTION PLAT

*320* Ft. from N. Line

Ft. from S. Line

Ft. from E. Line

*339* Ft. from W. Line

		<i>0</i>	

COMPLETED

Location.....

Rig up.....

Drilling and Remarks:

*Quatern Sand*

*3378-82*

*Swath 25776*

RECORD

Cased.....in., .....ft.

Sand.....

Gas.....

Oil.....

Total Depth *3382*

PRODUCTION

1st 24 hrs. Nat.....

1st 24 hrs. after shot.....

Gas.....Cu. Ft.

Dry Hole.....

Abandoned.....

Date

MAY 15 1929

S. J. LEWIS

192.....

Scout