


Section 15 Township 31 Range 4E

Well No. 2 Summers

Company Aladdin Pet

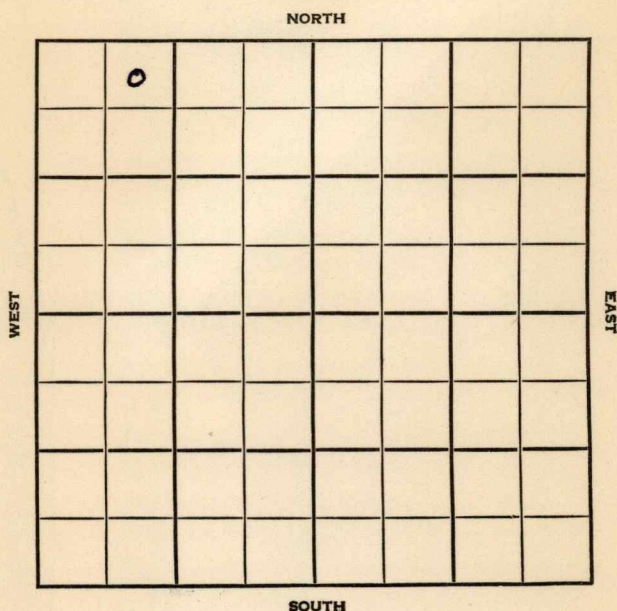

Cowley KANSAS

SEC. 15	TWP. 31	R. 4E
---------	---------	-------

WELL NO. 2 Summers FARM

COMPANY Alladdin Pet


CONTRACTOR Crowe Drlg.

330 _____ Ft. from N. Line

_____ Ft. from S. Line

_____ Ft. from E. Line

990 _____ Ft. from W. Line

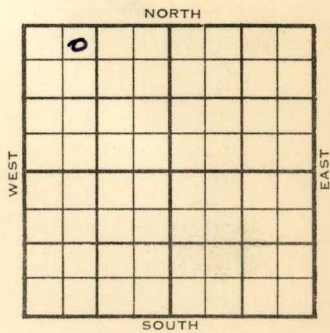

NE NW NW

1954	ELEVATION 1239	REPORT
------	----------------	--------

6/15	M I R
7/14	Spdg 6-14-54
	Oil well
	TD 2976
	8" @ 97
	Bart 2953
	TD 2976
	5" @ 2954 CO to 2976 frac Comp. 40
	bopd

COMPLETED

County **Cowley** State **Kansas**
Sec. **15** (Blk.) **31** (Sur.) **4E** Map No.
Operator **Aladdin Pet.**
Well No. **2** Farm **Summers**
Elev. Location **NE NW NW**

0							

FIRST REPORT

330Ft. From **N** Line **NW**
990Ft. From **W** Line Quarter
1st. Report **JUN 15 1954**
Completion
Remarks
Crowe Drig. - Contr.
Spudding Date

Drlg. Data

M I R

J. G. McGEHEE

County Cowley State KansasSec. 15 (Blk.) 31 (Sur.) 4E Map No.Operator Aladdin Pet.Well No. 2 Farm SummersElev. 1239 Location NE NW NW

0							

330 Ft. From N Line NW990 Ft. From W Line Quarter

1st. Report

Completion JUL 14 1954

Remarks

Crowe Drlg. - Contr.Spudding Date 6-14-54Drlg. Data Oil well TD 29768" @ 97 Bart. 2953 TD 29765" @ 2954 CO to 2976 fracComp. 40 bopd