


DX 78-1

Section 16 Township 31 Range 1E

Well No. 1 Hittle

Company Lindas Oil

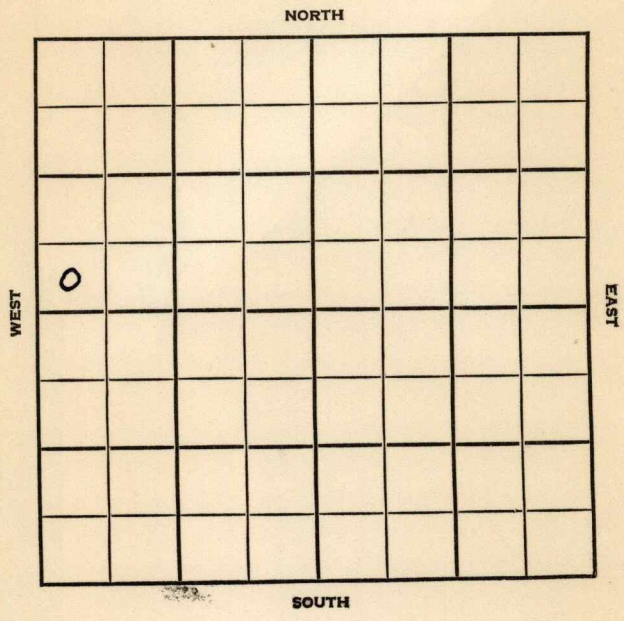

Cowley KANSAS

SEC. TWP. R.

WELL NO. 16 31 4E

COMPANY 1 Hittle FARM

CONTRACTOR Lindas Oil


Smitherman
Seni Wildcat

Ft. from N. Line

330 Ft. from S. Line

Ft. from E. Line

330 Ft. from W. Line

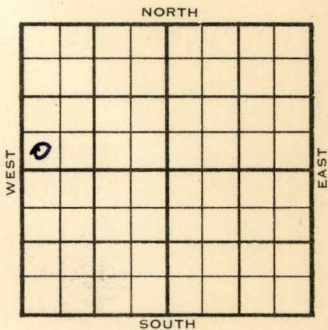

SW SW NW

	ELEVATION	REPORT
1954	1183	

7/28 8" @ 99

8-18 Spdg 8-2-54

D&A

TD 3379

8" @ 99

Stal 1937 KC 2333 Bart. 2880

Miss. 2990 Arb. 3371

DST 3372-77 open 1 hr. Rec. 3014' sw

TD 3379

D&A

ABANDONED

