


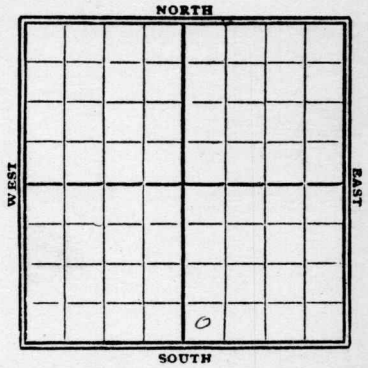

*Sedgwick*  
 Map No. KANSAS Sec. 6 Twp. 26 R. 1<sup>E</sup>  
 Well No. 3 - J. Goodrich (Farm)  
Bu - Vi - Bar Company

\_\_\_\_\_ Ft. from N. Line  
330 Ft. from S. Line  
 \_\_\_\_\_ Ft. from E. Line  
427 Ft. from W. Line



1929

Date	REPORT
1/30	Well at
2/16	
2/13	Reel
2/20	Reel
2/27	Spud
3/16	20 Reel 620'
3/13	" 1310'
3/20	" 1865'
3/27	" 2395'
4/3	" 2545'
4/10	" 2690'
4/17	" 2870'
4/24	Top Chat 3016' Reel 3035'
5/1	Base Miss line 3260 Reel 3382'
5/8	6" - 3353 Reel out Cement
5/15	Simpson 3369-74 T.D. 3374 swab 325 bbls oil Pump.

MAP No. KANSAS SEC. 6 TWP. 26 R. 1E

WELL No. K13 3 Tad Goodrich

Bu-Vi-Bar COMPANY

CONTRACTOR

SECTION PLAT


\_\_\_\_\_ FT. FROM N. LINE

330 FT. FROM S. LINE

\_\_\_\_\_ FT. FROM E. LINE

427 FT. FROM W. LINE

FIRST REPORTS

LOCATION \_\_\_\_\_

RIG UP \_\_\_\_\_

DRILLING AND REMARKS:

Cellar

RECORD

CASED \_\_\_\_\_ IN., \_\_\_\_\_ FT.

SAND \_\_\_\_\_

GAS \_\_\_\_\_

OIL \_\_\_\_\_

TOTAL DEPTH \_\_\_\_\_

PRODUCTION

1ST 24 HRS. NAT. \_\_\_\_\_

1ST 24 HRS. AFTER SHOT \_\_\_\_\_

GAS \_\_\_\_\_ CU. FT.

DRY HOLE \_\_\_\_\_

ABANDONED \_\_\_\_\_

DATE

JAN 30 1929

192

S. J. LEWIS

SCOUT

Map No. **KANSAS** Sec. **6** Twp. **26** R. **1E**

Well No. **3** **Paul Goodrick**

**Bu Vi Bar et al** Company

Contractor

SECTION PLAT


.....Ft. from N. Line

**330** Ft. from S. Line

.....Ft. from E. Line

**427** Ft. from W. Line

COMPLETED

Location.....

Rig up.....

Drilling and Remarks:

*Simpson 3369*

*3374*

*Swaff 32574*

RECORD

Cased.....in., .....ft.

Sand.....

Gas.....

Oil.....

Total Depth **3374**

PRODUCTION

1st 24 hrs. Nat.....

1st 24 hrs. after shot.....

Gas..... Cu. Ft.

Dry Hole.....

Abandoned.....

Date

MAY 15 1929

192.....

S. J. LEWIS

Scout