


KANSAS Cowley

FORM 51 5M PETROL

Section 15 Township 31 Range 4-E

Well No. #1 W. Gretsinger "A"

Company Hacathorn Drlg.

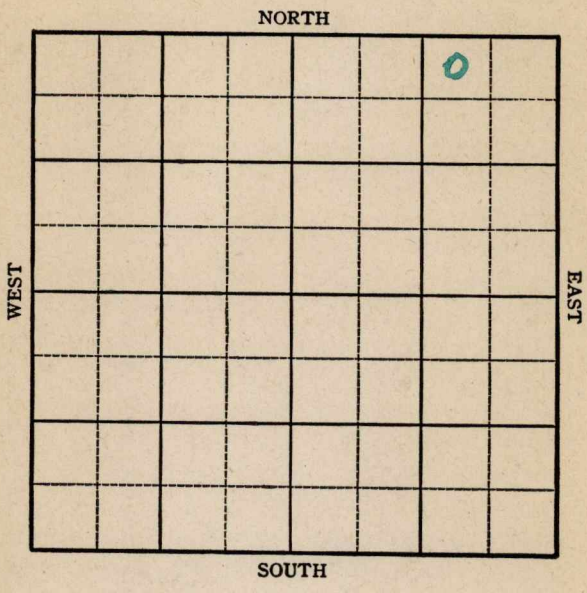

Sec. 15 Twp. 31 R. 4-E

Well No. #1 W. Grestsinger "A" Farm


Hacethorn Drlg. Company

330 Ft. from N. Line

\_\_\_\_\_ Ft. from S. Line

990 Ft. from E. Line

\_\_\_\_\_ Ft. from W. Line

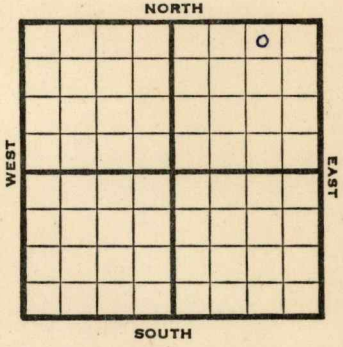

NW NE NE

1945 **Elev. 1260'** REPORT

12/12 Derrick

12/20 "

12/29 "

1946

1/10 "

1/17 "

1/24 "

1/31 "

2/7 15" - 425' WOC.

2/14 12" - 947' Drlg. 1020'

2/21 Drlg. 1660'

2/28 8" - 2178'

Drlg. 2183'

3/7 **Bart 2966' Miss 3001'**

Drlg. 3015'

3/14 Fsg 3067'

3/21 Drlg. 3100'

3/28 **Arb. 3462' T. D. 3464'**  
250' of fluid 1 hour, 50% water.

4/3 **Arb. 3462**

6" @ 3000

TD 3464

Pump 80 oil plus 100 W. Pot.

Grav. 40.7

**COMPLETED**



**KANSAS**

Kansas

Pool Name Miscellaneous

Map No. 2 Sec. 15 Twp. 31 R. 4E

Well No. 1 W. Grestsinger "A"

Hacethorn Drlg. Company

**COMPLETED**

Contractor

*F. 1260*

NW NE NE

**SECTION PLAT**

330 Ft. from N. Line

\_\_\_\_\_ Ft. from S. Line

990 Ft. from E. Line

\_\_\_\_\_ Ft. from W. Line

			0

Cowley County

Location \_\_\_\_\_

Rig up \_\_\_\_\_

Drilling and Remarks:

*Ar 73462*

*6" @ 3000*

*Pump 50 oil + 100 W  
Pot.*

*40 7 94*

**RECORD**

Cased \_\_\_\_\_ in., \_\_\_\_\_ ft.

Sand \_\_\_\_\_

Gas \_\_\_\_\_

Oil \_\_\_\_\_

Total Depth 3464

**PRODUCTION**

1st 24 hrs. Nat. \_\_\_\_\_

1st 24 hrs. after shot \_\_\_\_\_

Gas \_\_\_\_\_ Cu. Ft.

Dry Hole \_\_\_\_\_

Abandoned \_\_\_\_\_

Date

APR 3 1946

19

S. J. LEWIS

Scout