

Sedywick


Form 51-5M-2-29-34703

Map No. **KANSAS** Sec. *6* Twp. *26* R. *1E*

Well No. *5 - Tad Goodrich* Farm

Bu-Vi-Bar et al Company

NORTH

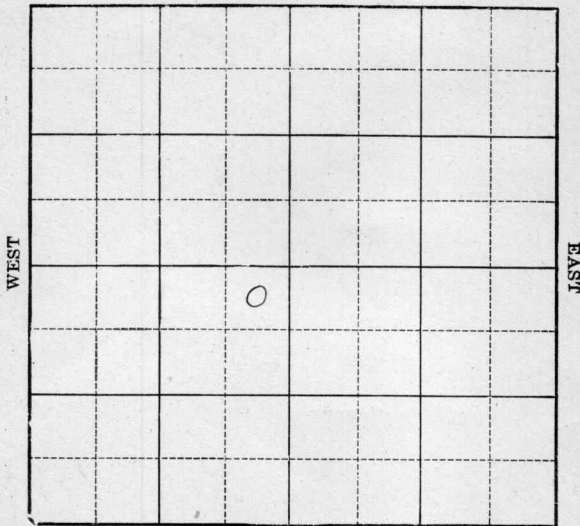

SOUTH

OWDID

Location _____

Drilling Remarks _____

Rig Up _____

Drilling Remarks _____

RECORD

Cased _____ in. _____ ft.

Sand _____

Gas _____

Oil _____

Total Depth _____

PRODUCTION

1st 24 hrs. Nat. _____

1st 24 hrs. after shot _____

Gas _____ cu. ft.

Dry Hole _____

Abandoned _____


Map No. KANSAS Sec. 6 Twp. 26 R. 1E
Well No. 5 - J. Goodrich Farm
Bu-Vi-Bar etal Company

330 Ft. from N. Line

_____ Ft. from S. Line

330 Ft. from E. Line

_____ Ft. from W. Line

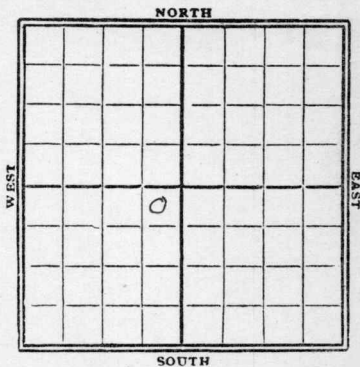

1929

Date	REPORT
3/13	83' Sur pipe.
3/20	10' rlg 1065'
3/27	" 1540'
4/3	" 2475'
4/10	" 3235
4/17	8" 3312
4/24	Temp sand 3362-66 TD. 3382' Pump 25 bbls oil Pomp.
1929	OWDD
5/1	old TD. 3382'
5/8	—
5/15	10' rlg 3391'
5/22	WR. 6" 3396
5/29	Wilson 3402-15 show oil and water
6/5	HFW 3423-26-S.D.
6/12	HFW 3423-26 TD. 3426' Abandoned

MAP No. 13 **KANSAS** SEC. 6 TWP. 26 R. 1E

WELL No. 5 Tack Gorchick

Bu-Vi Bar & Oil COMPANY

CONTRACTOR

SECTION PLAT

330 FT. FROM N. LINE
____ FT. FROM S. LINE
330 FT. FROM E. LINE
____ FT. FROM W. LINE

FIRST REPORTS

LOCATION _____

RIG UP _____

DRILLING AND REMARKS:

83' Surface Pipe

RECORD

CASED _____ IN. _____ FT.

SAND _____

GAS _____

OIL _____

TOTAL DEPTH _____

PRODUCTION

1ST 24 HRS. NAT. _____

1ST 24 HRS. AFTER SHOT _____

GAS _____ CU. FT.

DRY HOLE _____

ABANDONED _____

DATE

MAR 13 1929

192

S. J. LEWIS

SCOUT

Map No. *13* **KANSAS** Sec. *6* Twp. *26* R. *15*

Well No. *5 Tad Goodrich*

Burk & Bar Company

Contractor

SECTION PLAT

320 Ft. from N. Line

..... Ft. from S. Line

330 Ft. from E. Line

..... Ft. from W. Line

		o	

COMPLETED

Location.....

Rig up.....

Drilling and Remarks:

Simplex Sand
3362 to 66.

Pump 25 Hk.

RECORD

Cased..... in., ft.

Sand.....

Gas.....

Oil.....

Total Depth. *3382*

PRODUCTION

1st 24 hrs. Nat.....

1st 24 hrs. after shot.....

Gas..... Cu. Ft.

Dry Hole.....

Abandoned.....

Date

APR 24 1929

192

S. J. LEWIS

Scout

Map No. *13* **KANSAS** Sec. *6* Twp. *26* R. *12⁷*

Well No. *5* *Thos. Goodrich*

Bur Vi Bar & Dal. Company

Contractor

SECTION PLAT

330 Ft. from N. Line

..... Ft. from S. Line

330 Ft. from E. Line

..... Ft. from W. Line

		<i>6</i>	

OW□□

Location.....

Rig up.....

Drilling and Remarks:

Old total depth

3382

RECORD

Cased..... in., ft.

Sand.....

Gas.....

Oil.....

Total Depth.....

PRODUCTION

1st 24 hrs. Nat.....

1st 24 hrs. after shot.....

Gas..... Cu. Ft.

Dry Hole.....

Abandoned.....

Date

MAY 1 1929

S. J. LEWIS Scout

Map No. KANSAS Sec. 6 Twp. 26 R. 1E

Well No. 5 Paul Garlich

Bu Vi Bar & Dal Company

Contractor

SECTION PLAT

330 Ft. from N. Line

..... Ft. from S. Line

330 Ft. from E. Line

..... Ft. from W. Line

ABANDONED

Location.....

Rig up.....

Drilling and Remarks:

AFW 3423-26

DA

RECORD

Cased.....in.,ft.

Sand.....

Gas.....

Oil.....

Total Depth 3426

PRODUCTION

1st 24 hrs. Nat.....

1st 24 hrs. after shot.....

Gas.....Cu. Ft.

Dry Hole.....

Abandoned.....

Date

JUN 12 1920

S. J. LEWIS Scout