Sedgwick


Form 51—5M—9-28—27423

Map No. KANSAS Sec. 26 Twp. 26 R. 1E

Well No. 1-Gorham Farm

Derby Oil Company

NORTH (Gorman)

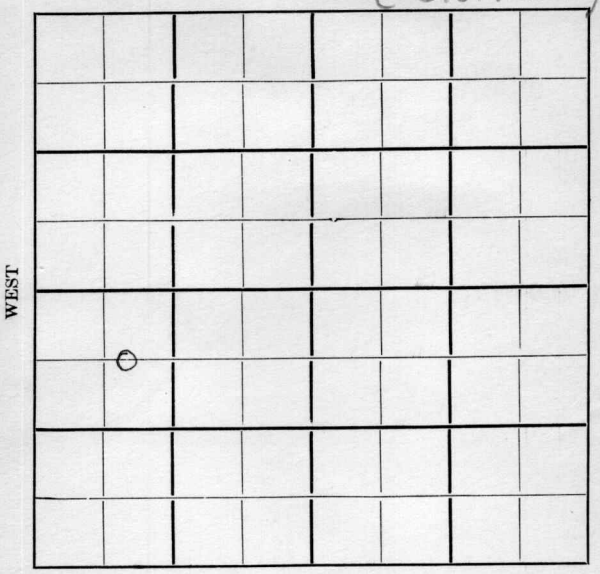

Location

Drilling Remarks

Rig Up

Drilling Remarks

RECORD

Cased ..... in. ..... ft.

Sand

Gas

Oil

Total Depth

PRODUCTION

1st 24 hrs. Nat.

1st 24 hrs. after shot

Gas. ..... cu. ft.

Dry Hole

Abandoned

Sedgwick

Form 252A—5M—5-28—Mid-West

Map No. KANSAS Sec. 26 Twp. 26 R. 1E

Well No. 1 - Gorham Farm


Derby Oil Company

665 Ft. from N. Line

Ft. from S. Line

Ft. from E. Line

839 Ft. from W. Line

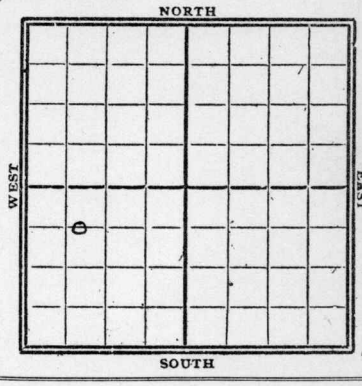

1929

Date	REPORT
1/9	Location
1/16	Rig
1/23	Spud
1/30	Drlg 425'
2/6	" 1030'
2/13	" 1800'
2/20	" 2200'
2/27	oil 2560-75'
	drlg 2680'
3/6	Top Chat 2995'
	Drlg 3030'
3/13	" 3053'
3/20	" 3255'
3/27	" 3350'
4/1	Log Pay 3364-69
	Swab 25 bbls
	24 hrs - will deepen
4/3	Dump sand 3364-74
	T.D. 3374'
	swab 1000 bbls oil
	Comp.
4/5	907 bbls oil

4/9- 725 bbls

Form 26c-1M Rks. 9-28

Berg-Dick

Map No. KANSAS Sec. 6 Twp. 26 R. 1E


K13

Well No. 1 Gorman

Derby Oil Company

Contractor

SECTION PLAT

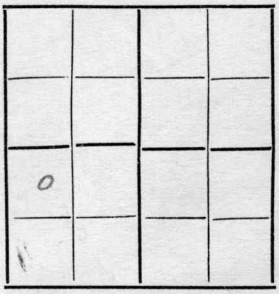

665 Ft. from N. Line

Ft. from S. Line

Ft. from E. Line

839 Ft. from W. Line

FIRST REPORTS

Location ✓

Rig up

Drilling and Remarks:

RECORD

Cased in., ft.

Sand

Gas

Oil

Total Depth

PRODUCTION

1st 24 hrs. Nat.

1st 24 hrs. after shot

Gas Cu. Ft.

Dry Hole

Abandoned

Date

JAN 9 1929

192

S. J. LEWIS Scout

Form 26—1M Bks.—9-26

Bridwick


Map No. 1/2 KANSAS Sec. 6 Twp. 26 R. 14E

Well No. 1 Gorman

Derby Oil Company

Contractor

SECTION PLAT

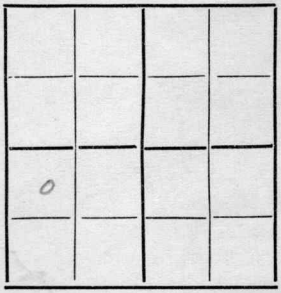

665 Ft. from N. Line

Ft. from S. Line

Ft. from E. Line

839 Ft. from W. Line

COMPLETED

Location

Rig up

Drilling and Remarks:

Simpson Sand
3864 & 3874

Swab 1000 BW

RECORD

Cased in., ft.

Sand

Gas

Oil

Total Depth 3874

PRODUCTION

1st 24 hrs. Nat.

1st 24 hrs. after shot

Gas Cu. Ft.

Dry Hole

Abandoned

Date

APR 3 1929

192

S. J. LEWIS Scout

Form 26—1M Bks.—2-29

39 KANSAS


Map No. _____ Sec. 6 Twp. 26 R. 1 E

Well No. 1 Germaw

Derby Oil Co Company

_____ Contractor

SECTION PLAT

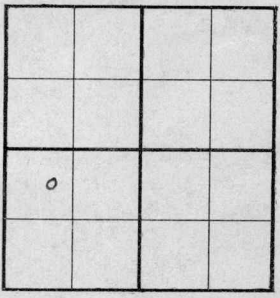

665 Ft. from N. Line

_____ Ft. from S. Line

_____ Ft. from E. Line

839 Ft. from W. Line

ABANDONED

Location _____

Rig up _____

Drilling and Remarks:

Plugged 7/1/31

RECORD

Cased _____ in., _____ ft.

Sand _____

Gas _____

Oil _____

Total Depth 3374

PRODUCTION

1st 24 hrs. Nat. _____

1st 24 hrs. after shot _____

Gas _____ Cu. Ft.

Dry Hole _____

Abandoned _____

Date

JAN 30 1932

_____ 19

CHAS. L. SHERWOOD

_____ Scout