

*Sedgwick*


Form 51-5M-2-29-34703

Map No. KANSAS Sec. 6 Twp. 26 R. 1E

Well No. 3-Torman Farm

Derby Oil Company

NORTH

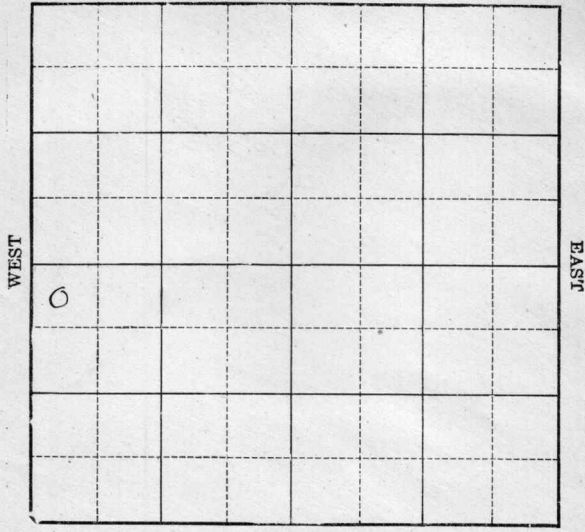

WEST

EAST

SOUTH

Location \_\_\_\_\_

Drilling Remarks \_\_\_\_\_

Rig Up \_\_\_\_\_

Drilling Remarks \_\_\_\_\_

**RECORD**

Cased \_\_\_\_\_ in. \_\_\_\_\_ ft.

Sand \_\_\_\_\_

Gas \_\_\_\_\_

Oil \_\_\_\_\_

Total Depth \_\_\_\_\_

**PRODUCTION**

1st 24 hrs. Nat. \_\_\_\_\_

1st 24 hrs. after shot \_\_\_\_\_

Gas \_\_\_\_\_ cu. ft.

Dry Hole \_\_\_\_\_

Abandoned \_\_\_\_\_

*Sedgwick*

Map No. KANSAS Sec. 69 Twp. 26 R. 1E

Well No. 3 - Gorham Farm


Herbey Oil Company

300 Ft. from N. Line

\_\_\_\_\_ Ft. from S. Line

\_\_\_\_\_ Ft. from E. Line

330 Ft. from W. Line

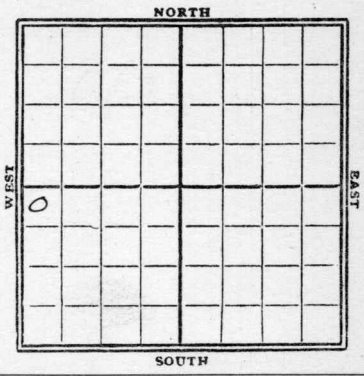

1929

Date REPORT

Date	REPORT
4/17	Rotary rig
4/24	Drill 1100'
5/1	" 2440'
5/8	" 3150'
5/15	8" 3304'
5/22	Simpson 3351-64 1/2'
	TD. 3364 1/2'
	swab 1017 bbl oil
	Comp.

Map No. *13* **KANSAS** Sec. *6* Twp. *26* R. *1E*

Well No. *3 Sorman*

*Deerby Oil* Company

Contractor

**SECTION PLAT**

*300* Ft. from N. Line

..... Ft. from S. Line

..... Ft. from E. Line

*330* Ft. from W. Line

<i>0</i>			

**FIRST REPORTS**

Location.....

Rig up.....

Drilling and Remarks:

*Rig Rotary*

**RECORD**

Cased..... in., ..... ft.

Sand.....

Gas.....

Oil.....

Total Depth.....

**PRODUCTION**

1st 24 hrs. Nat.....

1st 24 hrs. after shot.....

Gas..... Cu. Ft.

Dry Hole.....

Abandoned.....

Date

*APR 17 1929*

*S. J. LEWIS*

192.....

Scout

Map No. KANSAS Sec. 6 Twp. 26 R. 1E

Well No. 13 2 Gorman

Terry Oil Company

Contractor

SECTION PLAT

300 Ft. from N. Line

..... Ft. from S. Line

..... Ft. from E. Line

300 Ft. from W. Line

0			

COMPLETED

Location.....

Rig up.....

Drilling and Remarks:

*Simpson sand*  
*3351-64 1/2*

*Swath 10178H*

RECORD

Cased..... in., ..... ft.

Sand.....

Gas.....

Oil.....

Total Depth 3364 1/2

PRODUCTION

1st 24 hrs. Nat.....

1st 24 hrs. after shot.....

Gas..... Cu. Ft.

Dry Hole.....

Abandoned.....

Date

MAY 22 1929

192.....

S. J. LEWIS

Scout