

Map No. KANSAS Sec. 26 Twp. 26 R. 1E

Well No. 4 Sorman Farm


Herby Oil Company

665 Ft. from N. Line

_____ Ft. from S. Line

_____ Ft. from E. Line

275 Ft. from W. Line

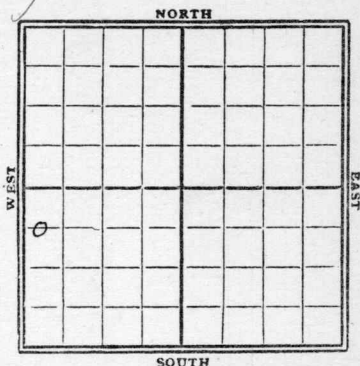

1929

Date

REPORT

Date	REPORT
4/24	Rotary
5/1	Herby 760'
5/8	" 2000'
5/15	" 2810'
5/22	" 3264'
5/29	8" - 3265'
6/5	Land 3362-64 1000' oil in hole
6/12	Simpson 3362-67 T.D. 3367 swab 625 bbl oil Comp.

Map No. KANSAS Sec. 6 Twp. 26 R. 1E

Well No. 4 Gorman

Deery Oil Company

Contractor

SECTION PLAT

665 Ft. from N. Line

..... Ft. from S. Line

..... Ft. from E. Line

275 Ft. from W. Line

FIRST REPORTS

Location.....

Rig up.....

Drilling and Remarks: Rotary

RECORD

Cased.....in.,ft.

Sand.....

Gas.....

Oil.....

Total Depth.....

PRODUCTION

1st 24 hrs. Nat.....

1st 24 hrs. after shot.....

Gas.....Cu. Ft.

Dry Hole.....

Abandoned.....

Date

APR 24 1929

192.....

S. J. LEWIS

Scout

Map No. KANSAS Sec. 6 Twp. 26 R. 1E

Well No. 4 German

Merby Oil Company

Contractor

SECTION PLAT

o			

665 Ft. from N. Line

..... Ft. from S. Line

..... Ft. from E. Line

275 Ft. from W. Line

COMPLETED

Location.....

Rig up.....

Drilling and Remarks:

Simpson 3362-8367

Sway 62588

RECORD

Cased.....in.,ft.

Sand.....

Gas.....

Oil.....

Total Depth 3367

PRODUCTION

1st 24 hrs. Nat.....

1st 24 hrs. after shot.....

Gas.....Cu. Ft.

Dry Hole.....

Abandoned.....

Date

JUN 12 1929

.....192.....

S. J. LEWIS

Scout