

KANSAS


Cowley

FORM 51 5M 1-42 PETROL

Section 17 Township 31 Range 4-E

Well No. #1 Martin

Company Winkler & Koch & Wakefield

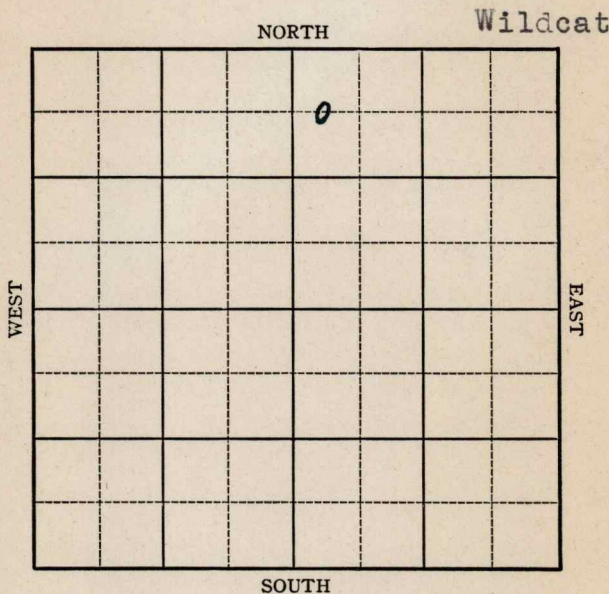

KANSAS


Cowley

Sec. 17 Twp. 31 R. 4-EWell No. #1 Martin FarmWinkler & Koch & Wakefield Company

(Wildcat)

660 Ft. from N. Line Ft. from S. Line Ft. from E. Line330 Ft. from W. Line

Elev. 1173

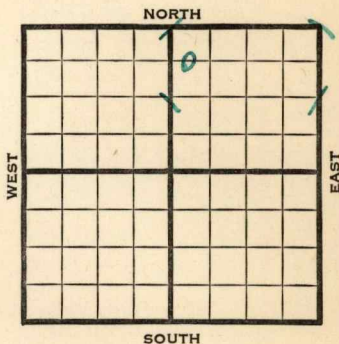

1942	REPORT
2/4	Cable.
2/12	"
2/19	"
2/26	"
3/5	Drlg. 565'
3/12	15" - 470' 12" - 1015' Drlg. 1360'
3/19	10" - 1710' Drlg. 2010'
3/26	Topeka 1273' Stal. 1940'
	Drlg. 2295'
4/2	K.C. 2375' Drlg. 2750'
4/8	Chat. 2983' Miss. 3007'
	7" - 3021' Drlg. 3185'
4/15	Miss. 2985' (Corrected)
	Arb. 3370'
	T.D. 3382'
	No shows.
	ABANDONED

Map No. 2 Sec. 17 Twp. 31 R. 4EWell No. 1 MartinWinkler & Koch & CompanyWakefield**FIRST REPORT**

Contractor

C WL NW NE


660 Ft. from N. Line

Ft. from S. Line

Ft. from E. Line

330 Ft. from W. Line

SECTION PLAT

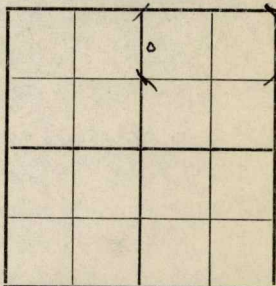**WILDCAT**

Location _____

Rig up _____

Drilling and Remarks:

Cable

RECORD

Cased _____ in., _____ ft.

Sand _____

Gas _____

Oil _____

Total Depth _____

PRODUCTION

1st 24 hrs. Nat. _____

1st 24 hrs. after shot _____

Gas _____ Cu. Ft.

Dry Hole _____

Abandoned _____

Date

FEB 4 1942 19S. J. LEWIS Scout

Map No. 2 Sec. 17 Twp. 31 R. 4EWell No. 1 MartinWinkler & Koch & Wakefield Company**ABANDONED**

Contractor

C WL NW NE

SECTION PLAT

660 Ft. from N. Line Ft. from S. Line Ft. from E. Line330 Ft. from W. Line

WILDCAT

RECORD

Location Cased in., ft.Rig up Sand

Drilling and Remarks:

Gas Oil Total Depth 3372

PRODUCTION

1st 24 hrs. Nat. 1st 24 hrs. after shot Gas Cu. Ft.Dry Hole Abandoned

Date

APR 15 1942 19

S. J. LEWIS

Scout