


Sedgwick
 Map No. **KANSAS** Sec. *6* Twp. *26* R. *1E*

Well No. *2-Lavender* Farm
Montour Oil Company

NORTH

WEST

EAST

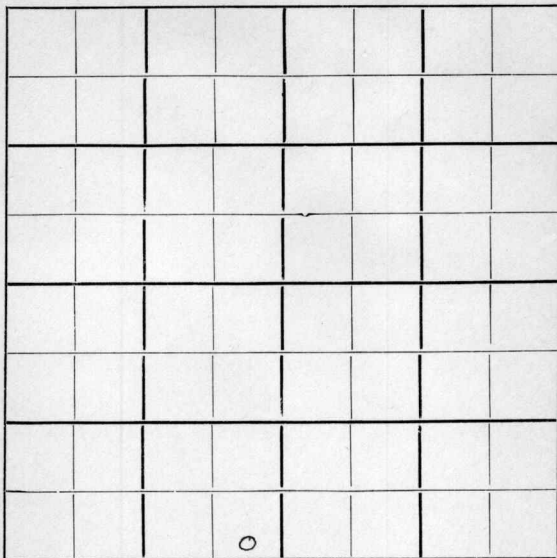

SOUTH

Location.....

Drilling Remarks

Rig Up.....

Drilling Remarks

.....

.....

RECORD

Cased..... in..... ft.
 Sand.....
 Gas.....
 Oil.....
 Total Depth.....

PRODUCTION


1st 24 hrs. Nat.....
 1st 24 hrs. after shot.....
 Gas..... cu. ft.....
 Dry Hole.....
 Abandoned.....

Sedgwick

Map No. KANSAS Sec. 6 Twp. 26 R. 1E

Well No. 2 - Lavender Farm
Montour Oil Company

_____ Ft. from N. Line
150 Ft. from S. Line
 _____ Ft. from E. Line
2349 Ft. from W. Line

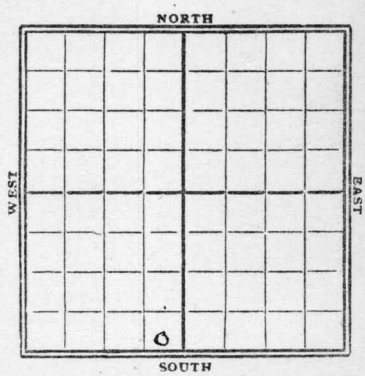

1929

Date	REPORT
<u>1/16</u>	<u>Location</u>
<u>1/23</u>	
<u>1/30</u>	<u>Spillar</u>
<u>2/16</u>	<u>Reg</u>
<u>2/13</u>	<u>Reg in</u>
<u>2/20</u>	<u>drly 1980'</u>
<u>2/27</u>	<u>" 2110'</u>
<u>3/6</u>	<u>fsy tools 2110'</u>
<u>3/13</u>	<u>drly 2010</u>
<u>3/20</u>	<u>" 2420'</u>
<u>3/27</u>	<u>" 2865'</u>
<u>4/3</u>	<u>" 2950'</u>
<u>4/10</u>	<u>" 3038'</u>
	<u>top chat 3032</u>
<u>4/17</u>	<u>drly 3240'</u>
<u>4/24</u>	<u>Sept 6" - 3327'</u>
<u>5/1</u>	<u>Comp. 3379-85</u>
	<u>TD. 3385'</u>
	<u>swab 1187 bbls.</u>
	<u>Pomp.</u>

Belgwick

MAP NO. KANSAS SEC. 6 TWP. 26 R. 1E

WELL NO. 2 Lavender

K13 Montour Oil COMPANY

CONTRACTOR

SECTION PLAT

_____ FT. FROM N. LINE

150 FT. FROM S. LINE

_____ FT. FROM E. LINE

2349 FT. FROM W. LINE

FIRST REPORTS

LOCATION ✓

RIG UP _____

DRILLING AND REMARKS:

RECORD

CASED _____ IN. _____ FT.

SAND _____

GAS _____

OIL _____

TOTAL DEPTH _____

PRODUCTION

1ST 24 HRS. NAT. _____

1ST 24 HRS. AFTER SHOT _____

GAS _____ CU. FT.

DRY HOLE _____

ABANDONED _____

DATE

JAN 16 1929

S. J. LEWIS

192

SCOUT

Map No. KANSAS Sec. 6 Twp. 26 R. 1E

Well No. 13 2 Lawrence

Montour Oil Company

Contractor

SECTION PLAT

20 Ft. from N. Line

100 Ft. from S. Line

Ft. from E. Line

2349 Ft. from W. Line

COMPLETED

Location.....

Rig up.....

Drilling and Remarks:

Simpson
3379-85

Swatt

1187 1/2

RECORD

Cased.....in.,ft.

Sand.....

Gas.....

Oil.....

Total Depth 3385

PRODUCTION

1st 24 hrs. Nat.....

1st 24 hrs. after shot.....

Gas.....Cu. Ft.

Dry Hole.....

Abandoned.....

Date

MAY 1 1929

S. J. LEWIS

Scout