


Map No. **KANSAS** Sec. *6* Twp. *26* R. *1E*
Well No. *1 Miesner* Farm
Sovereign Oil Company

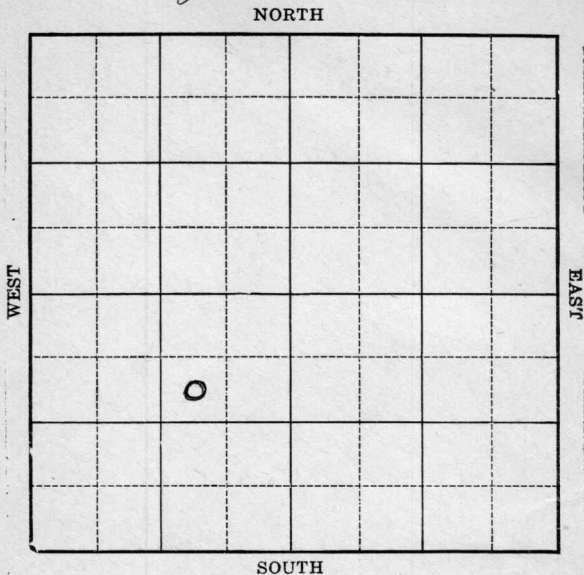

Location _____

Drilling Remarks _____

Rig Up _____

Drilling Remarks _____

RECORD

Cased _____ in. _____ ft.
Sand _____
Gas _____
Oil _____
Total Depth _____

PRODUCTION

1st 24 hrs. Nat. _____
1st 24 hrs. after shot _____
Gas _____ cu. ft.
Dry Hole _____
Abandoned _____


Sedgwick

Map No. **KANSAS** Sec. 6 Twp. 26 R. 1 EWell No. 1 Niessen FarmSovereign Oil Company990 Ft. from N. Line

Ft. from S. Line

990 Ft. from E. Line

Ft. from W. Line

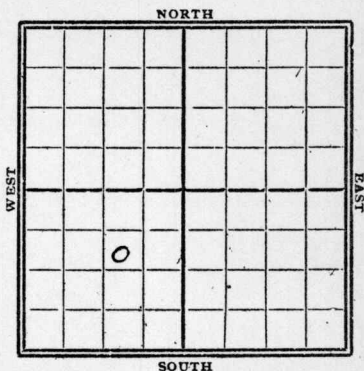Date
7/3/34

REPORT

4/4 Drlg 17304/12 " 22204/19 S.D. 22204/26 Dlg 2567 6" 23725/3 5 3/16 2594 K.C. 2594-97Swab 10 BBl oil 1000 gal acid5/9 K.C.L. 2594-97 1000 acid
83 oil 10 water

COMPLETED

KANSAS

Map No. 13 Sec. 6 Twp. 26 R. 1EWell No. 1-NiessenSovereign Oil Company

Contractor

FIRST REPORT

SECTION PLAT

990 Ft. from N. Line

_____ Ft. from S. Line

990 Ft. from E. Line

_____ Ft. from W. Line

Location _____

Rig up _____

Drilling and Remarks:

RECORD

Cased _____ in., _____ ft.

Sand _____

Gas _____

Oil _____

Total Depth _____

PRODUCTION

1st 24 hrs. Nat. _____

1st 24 hrs. after shot _____

Gas _____ Cu. Ft.

Dry Hole _____

Abandoned _____

Date

4-4-34

19

O. Marnscheck Scout

Map No. 13 Sec. 6 Twp. 26 R. 1 EWell No. 1-NielsenSovereign Oil Company

Contractor

COMPLETED

SECTION PLAT

990 Ft. from N. Line

_____ Ft. from S. Line

990 Ft. from E. Line

_____ Ft. from W. Line

Location _____

Rig up _____

Drilling and Remarks:

1000 acid83 oil
10 water

RECORD

Cased _____ in., _____ ft.

Sand K.C.L. 2594-97

Gas _____

Oil _____

Total Depth _____

PRODUCTION

1st 24 hrs. Nat. _____

1st 24 hrs. after shot _____

Gas _____ Cu. Ft.

Dry Hole _____

Abandoned _____

Date

ORVAL MANNSCHRECK

5-9-34 19

Scout