

Sedgwick


Form 51-5M-11-31-Palace

Map No. *KANSAS* Sec. *6* Twp. *26* R. *1E*

Well No. *1 Schurgen* Farm

Sovereign Oil Company

NORTH

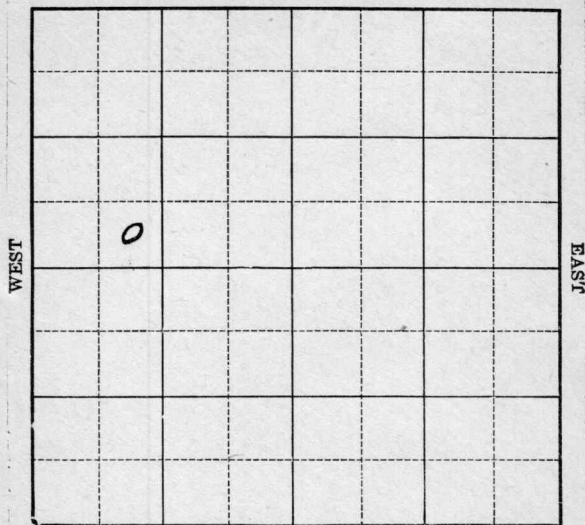

SOUTH

Twin

Location

Drilling Remarks

Rig Up

Drilling Remarks

RECORD

Cased in. ft.

Sand

Gas

Oil

Total Depth

PRODUCTION

1st 24 hrs. Nat.

1st 24 hrs. after shot

Gas cu. ft.

Dry Hole

Abandoned

Sedgwick

Map No. KANSAS Sec. 6 Twp. 26 R. 1E

Well No. 1 Scherger Farm

Sovereign Oil Company


 Ft. from N. Line

330 Ft. from S. Line

 Ft. from E. Line

990 Ft. from W. Line

- Twin Well -

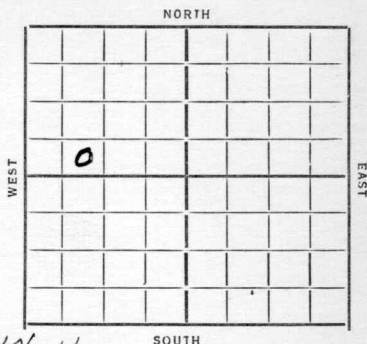

Date

REPORT

6/27 Machine dly 860
7/5 dly 1050
7/12
7/19 dly 1435 8" 1415
7/26
8/2 dly 1910
8/9 dly 1916
8/16 — 8/23 — 8/30 — 9/6 —
9/13 — 9/20 —
9/27 HFW 2325-35 TD 2350
Run 698
10/4 dly 2540
10/11 5 3/16 2562 dly plug
10/18 TD 2602 Oil 2580
Est 10 Bbls per day 1500 acid
10/25 Testing
11/1 Pay 2662-76 1000 acid
p 12 Bbls per hr.
11/7 Oil 2662-76 TD 2676
1000 acid 188 oil 15 water.

COMPLETED

Lequik KANSAS KANSAS
 Map No. 13 Sec. 6 Twp. 26 R. 1E

Well No. #1 Scherger

Sovereign Oil Company

Contractor

Twin well
 FIRST REPORTS

 Ft. from N. Line

330 Ft. from S. Line

 Ft. from E. Line

990 Ft. from W. Line

SECTION PLAT

Location

Rig up

Drilling and Remarks:

Machine

Reg 860

RECORD

Cased in., ft.

Sand

Gas

Oil

Total Depth

PRODUCTION

1st 24 hrs. Nat.

1st 24 hrs. after shot

Gas Cu. Ft.

Dry Hole

Abandoned

Date

6-27-34 19

ORVAL MANNSCHRECK
 Scout

Map No. 13 Sec. 6 Twp. 26 R. 1EWell No. 1-SchergenSovereign Oil Company

Contractor

COMPLETED

SECTION PLAT

0			

Ft. from N. Line

330 Ft. from S. Line

Ft. from E. Line

990 Ft. from W. Line

Location

Rig up

Drilling and Remarks:

1000 and188 oil
15 water

RECORD

Cased in., ft.

Sand

Gas

Oil 2662-76Total Depth 2676

PRODUCTION

1st 24 hrs. Nat.

1st 24 hrs. after shot

Gas Cu. Ft.

Dry Hole

Abandoned

Date

ORVAL MANNSCHRECK

11-7-34

192

Scout