Sedgwick


Form 51—5M—9-28—27423

Map No. KANSAS Sec. 7 Twp. 26 R. 1 E

Well No. 1 Byers Farm

Bu-Vi-Bar Mal Company

NORTH

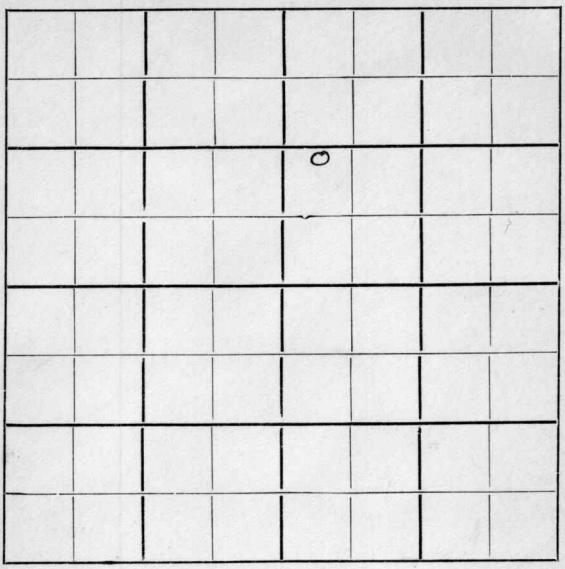

WEST EAST

SOUTH

Location	Rig Up
Drilling Remarks	Drilling Remarks

RECORD

Cased ..... in. ..... ft.

Sand .....

Gas .....

Oil .....

Total Depth .....

PRODUCTION

1st 24 hrs. Nat. .....

1st 24 hrs. after shot .....

Gas. ..... cu. ft. .....

Dry Hole .....

Abandoned .....

Sedgwick

FORM 252A-5M-12-28-PETROL

Map No. KANSAS Sec. 7 Twp. 26 R. 1E

Well No. 1 Byers Farm


Bu-Vi-Bar Stal Company

1390 Ft. from N. Line

_____ Ft. from S. Line

_____ Ft. from E. Line

444 Ft. from W. Line

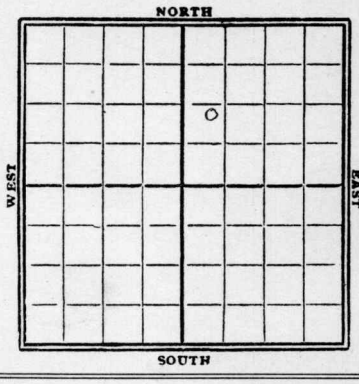

1929

Date	REPORT 5 A tract
1/30	Location
2/6	Cellar
2/13	Rig
2/20	Rigging up.
2/27	Spud 210'
3/6	Drlg 1600'
3/13	" 2380'
3/20	" 3150'
3/27	set 8" - 3317' Rust
4/1	Top pay 3368-75
	Pulled up 1500' oil
	in 2 hrs
4/3	Pump. sand 3368-75
	T.D. 3375'
	swab 343 bbl oil
	Comp.
4/5	273 bbls.
4/19	358 "

FORM 26-250-BKS, 4-28 WESTERN

Beeler

MAP NO. KANSAS SEC. 7 TWP. 26 R. 11E


413

WELL NO. 1 Byers

Bu-Vi-Bar Et al COMPANY

CONTRACTOR

SECTION PLAT

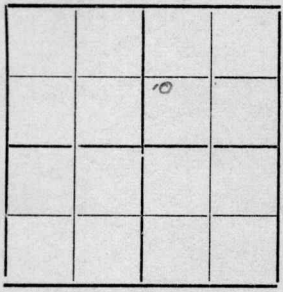

1390 FT. FROM N. LINE

FT. FROM S. LINE

FT. FROM E. LINE

444 FT. FROM W. LINE

FIRST REPORTS

LOCATION ✓

RIG UP

DRILLING AND REMARKS:

Farm tract

RECORD

CASED IN.. FT.

SAND

GAS

OIL

TOTAL DEPTH

PRODUCTION

1ST 24 HRS. NAT.

1ST 24 HRS. AFTER SHOT

GAS Cu. FT.

DRY HOLE

ABANDONED

DATE

JAN 30 1929

192

S. J. LEWIS SCOUT

Form 26—1M Bks.—9-26


Map No. KANSAS Sec. 7 Twp. 26 R. 14E

Well No. 1 Byers

Bu-Ki Bas & Fuel Company

Contractor

SECTION PLAT

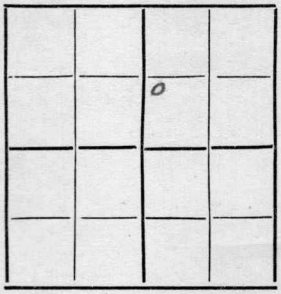

1890 Ft. from N. Line

Ft. from S. Line

Ft. from E. Line

444 Ft. from W. Line

COMPLETED

Location

Rig up

Drilling and Remarks:

Simpson Sand
3368 & 3376

Swab 8 3 hrs 8 Hrs

RECORD

Cased in., ft.

Sand

Gas

Oil

Total Depth 3375

PRODUCTION

1st 24 hrs. Nat.

1st 24 hrs. after shot

Gas Cu. Ft.

Dry Hole

Abandoned

Date

APR 3 1929

192

S. J. LEWIS Scout