


Cowley KANSAS

Section 21 Township 31 Range 4-E

Well No. #5 Goodrich (Twin)

Company Texas

NORTH Hittle Pool

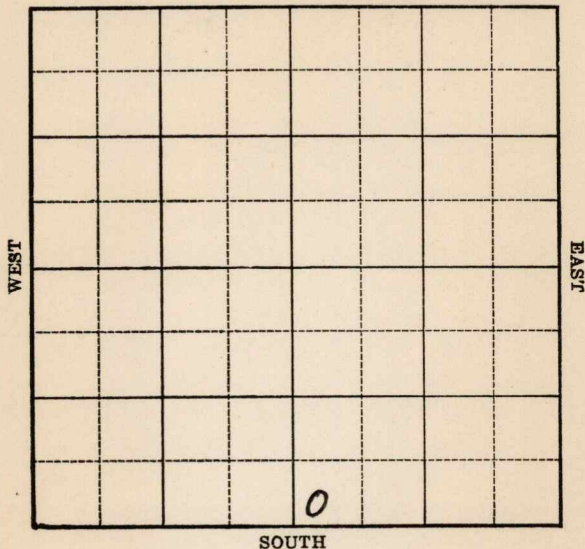

Cowley

KANSAS

Map No.

Sec.

21

Twp.

31

R.

4E

Well No.

5 Goodrich (Twin)

Texas

Company

Contractor

FIRST REPORT

SW SW SE

Ft. from N. Line

247

Ft. from S. Line

Ft. from E. Line

250

Ft. from W. Line

SECTION PLAT

HITTLE POOL

Location

RECORD

Cased in., ft.

Rig up

Sand

Drilling and Remarks:

Gas

ROTARY

Oil

Total Depth

PRODUCTION

1st 24 hrs. Nat.

1st 24 hrs. after shot

Gas

Cu. Ft.

Dry Hole

Abandoned

Date

JUN 7 1939 19

S. J. LEWIS

Scout

Map No. 2 Sec. 21 Twp. 31 R. 4EWell No. 5 Goodrich (Twin)Texas

Company _____

Contractor _____

COMPLETED

SW SW SE

_____ Ft. from N. Line

247 Ft. from S. Line

_____ Ft. from E. Line

250 Ft. from W. Line

HITTLE POOL

SECTION PLAT

Location _____

Rig up _____

Drilling and Remarks:

*CR 83279**6" C 3278**Bottom Hole pressure**from 8 5694**Maximum 3500*

RECORD

Cased _____ in., _____ ft.

Sand _____

Gas _____

Oil _____

Total Depth 3292

PRODUCTION

1st 24 hrs. Nat. _____

1st 24 hrs. after shot _____

Gas _____ Cu. Ft.

Dry Hole _____

Abandoned _____

Date

JUL 12 1939 19S. J. LEWIS Scout