


Cowley

Map No. *15* Sec. *20* Twp. *31* R. *4*

Well No. *1-~~Wentley~~ Hughes* Farm
M. J. Brin Company

NORTH

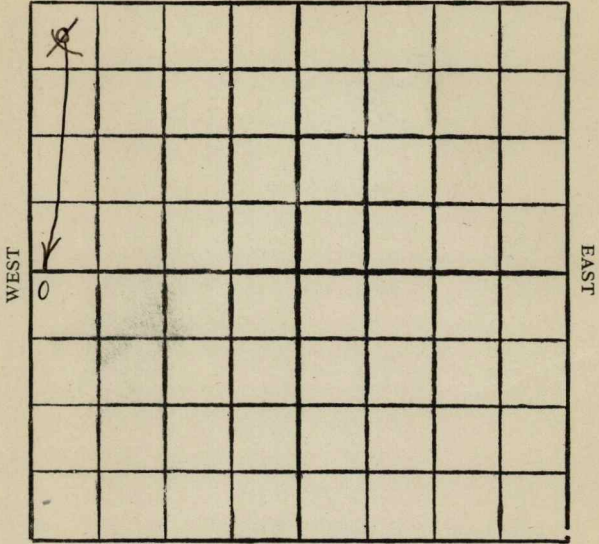

SOUTH

Location

Rig Up

Drilling Remarks

Drilling Remarks

.....

.....

RECORD

PRODUCTION

Cased in. ft.

Sand

Gas

Oil

Total Depth

1st 24 hrs. Nat.

1st 24 hrs. after shot

Gas cu. ft.

Dry Hole

Abandoned

Cowley Co.

Map No. KS Sec. 20 Twp. 31 R. 4


Well No. 1- Weakley Hughes Farm
M. J. Brin Company

320 Ft. from N. Line

_____ Ft. from S. Line

_____ Ft. from E. Line

320 Ft. from W. Line

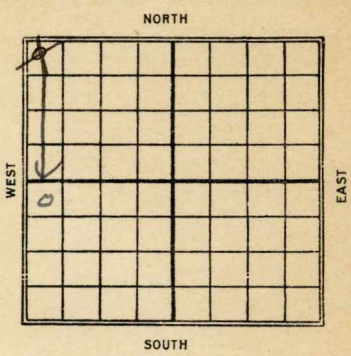

Date	REPORT
1926	
12/8	Location
12/15	Timbers
12/22	Rig
12/30	Spudded & S.D.
1927	
1/6	same
1/13	_____
1/19	_____
1/26	_____
2/3	_____
2/10	_____
2/17	_____
2/24	_____
3/2	_____
3/9	_____
3/16	Spudding
3/24	S.D. 375
3/30	Drly 500 - Manhattan Oil (Co. bought half interest)
4/7	Drly 905
4/13	" 1025
4/20	" 1235
4/27	" 1555

5/5 - S.D. 1600 for 10"

5/12 - S.D. 1623 for 10"

5/18 _____

5/25 _____

6/1 _____

6/7 _____

6/15 _____

6/22 _____

6/29 _____

Sand 2495-2510 - H.F.W.
Ady line 2898-2908
Top chat 2950-60
Base line 3235
Wilco 3280-90 show gas
Sbk. line 3349-528
H.F.W. D & D
11/30/27

7/7 Setting 10" - 1645"

7/13 - fishing 10" - 1730'

7/20 - Repairing rig 1875-

7/29 - Drlg 1900-

8/4 - " 2050
8/10 - Setting 8" - 2100 - Drlg 2110-

8/18 - S.D. 2110'

8/24 _____

9/1 _____

9/7 _____

9/14 - Setting 6" - 2385

9/29 - Sand 2495-2510 -
H.F.W. - Shut down 2685-

10/6 - Setting 5" - 2685

10/12 - T.D. 2735 - U.R. -

10/19 - Drlg 2875 - H.F.W. -

~~10/27 - sand 2495-2510 H.F.W.~~

~~1/2 m gas + small show~~

~~oil, sand 2525-2535~~

~~T.D. 2537 1 1/2 m gas~~

10/27 - Sand 2495-2510 - H.F.W.
U.R. 5" - 2920 - T.D.

11/2 - Sand 2495-2510 - H.F.W.
U.R. 6" - 2920 - T.D.

11/9 - Ady line 2898-2908 -
Top chat 2950-60 - drlg 3005.

11/16 - Drlg - 3120 in line -

Cowley

2 KANSAS 20 31 4
Map No. Sec. Twp. R.

1 Weakley
M. G. Brin
Well No. Company

Contractor

FIRST REPORTS

SECTION PLAT

320 Ft. from N. Line
Ft. from S. Line
Ft. from E. Line
320 Ft. from W. Line

0			

Location ✓
Rig up
Drilling and Remarks:

RECORD

Cased _____ in., _____ ft.
Sand _____
Gas _____
Oil _____
Total Depth _____

PRODUCTION

1st 24 hrs. Nat. _____
1st 24 hrs. after shot _____
Gas _____ Cu. Ft.
Dry Hole _____
Abandoned _____

Date DEC 8 1926 CHAS. L. SHERWOOD
192 Scout

Cowley

2 KANSAS Map No. Sec. 20 Twp. 31 R. 4

Well No. 1 Hughes

M. J. Brun Company

Contractor

CORRECTION

SECTION PLAT

320 Ft. from N. Line

Ft. from S. Line

Ft. from E. Line

320 Ft. from W. Line

0			
↓			
0			

Location

Rig up Sumbers

Drilling and Remarks:

chg loc &

Falm name.

RECORD

Cased in., ft.

Sand

Gas

Oil

Total Depth

PRODUCTION

1st 24 hrs. Nat.

1st 24 hrs. after shot

Gas Cu. Ft.

Dry Hole

Abandoned

Date DEC 15 1926

CHAS. L. SHERWOOD

Carney

MAP NO. **K2** **KANSAS** SEC. **20** TWP. **31S** R. **4E**

WELL NO. _____

Hughes
M. J. Babin

COMPANY _____

CONTRACTOR _____

SECTION PLAT

ABANDONED

_____ FT. FROM N. LINE

_____ FT. FROM S. LINE

_____ FT. FROM E. LINE

_____ FT. FROM W. LINE

0			

LOCATION _____

RIG UP _____

DRILLING AND REMARKS:

RECORD

CASED _____ IN. _____ FT.

SAND _____

GAS _____

OIL _____

TOTAL DEPTH 3352 1/2

PRODUCTION

1ST 24 HRS. NAT. _____

1ST 24 HRS. AFTER SHOT _____

GAS _____ CU. FT.

DRY HOLE

ABANDONED

DATE

11/29 192 *7*

SCOUT _____

Cowley

2 KANSAS Map No. Sec. 20 Twp. 31 R. 4

Well No. 1 Hughes

H. J. Brin

Company

Contractor

COMPLETED

SECTION PLAT

320

Ft. from N. Line

Ft. from S. Line

Ft. from E. Line

320

Ft. from W. Line

0			

ABANDONED

Location

Rig up

Drilling and Remarks:

Sand 2495-2510 AFW
 Sdy lime 2898-2908
 Top chert 2950-60
 Bezp lime 3235
 Wilcox 3280-90 show 960
 Silc lime 3349-52 1/2
 AFW. 2941

RECORD

Cased in., ft.

Sand

Gas

Oil

Total Depth 3352 1/2 AFW

PRODUCTION

1st 24 hrs. Nat.

1st 24 hrs. after shot

Gas Cu. Ft.

Dry Hole

Abandoned

Date

NOV 30 1927

CHAS. L. SHERWOOD

192

Scout