


Cowley Co

Map No. Kansas Sec. 21 Twp. 31 R. 4

Well No. 1 Goodrich Farm

Twin States Company

NORTH

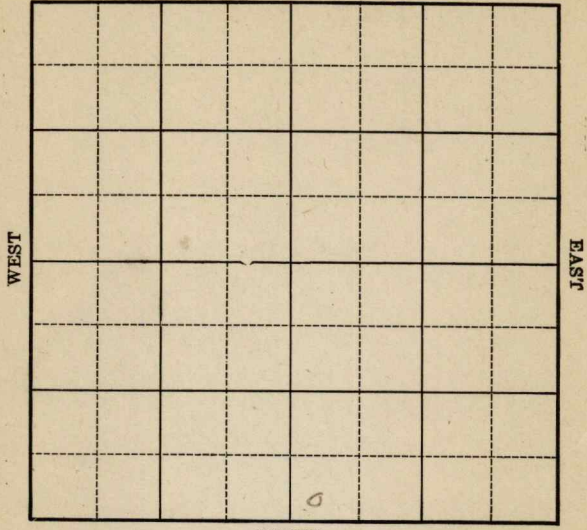

SOUTH

Location _____

Rig Up _____

Drilling Remarks _____

Drilling Remarks _____

RECORD

PRODUCTION

Cased _____ in. _____ ft.

1st 24 hrs. Nat. _____

Sand _____

1st 24 hrs. after shot _____

Gas _____

Gas _____ cu. ft.

Oil _____

Dry Hole _____

Total Depth _____

Abandoned _____


Cowley Co

Map No. Kansas Sec. 21 Twp. 31 R 4

Well No. 1 Goodrich Farm

Twin States Company

NORTH

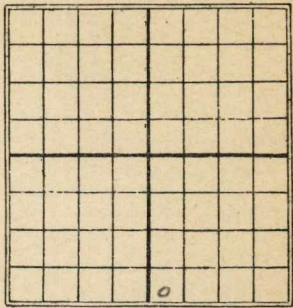

_____ Ft. from N. Line

330 Ft. from S. Line

_____ Ft. from E. Line

330 Ft. from W. Line

Date	REPORT
<u>1925</u>	
<u>10/29</u>	<u>Timbers</u>
<u>11/6</u>	_____
<u>11-13</u>	_____
<u>11-19</u>	_____
<u>11/27</u>	_____
<u>12/3</u>	_____
<u>12/10</u>	_____
<u>12/17</u>	_____
<u>12/23</u>	_____
<u>12/31</u>	_____
<u>1926</u>	
<u>1/8</u>	_____
<u>1/14</u>	_____
<u>1/20</u>	_____
<u>1/27</u>	_____
<u>2/4</u>	_____
<u>2/10</u>	_____
<u>2/17</u>	_____
<u>3/5</u>	_____
<u>3/11</u>	<u>Abandoned Location</u>

Cowley Co

Map No. *K2* KANSAS Sec. *21* Twp. *31* R. *4*

Well No. *1* *Goodrich*

Lewis States Company

Contractor

FIRST REPORTS

SECTION PLAT

----- Ft. from N. Line

330

----- Ft. from S. Line

----- Ft. from E. Line

330

----- Ft. from W. Line

Location -----

Rig up ----- *Lumbers*

Drilling and Remarks:

RECORD

Cased ----- in., ----- ft.

Sand -----

Gas -----

Oil -----

Total Depth -----

PRODUCTION

1st 24 hrs. Nat. -----

1st 24 hrs. after shot -----

Gas ----- Cu. Ft.

Dry Hole -----

Abandoned -----

Date

OCT 29 1925

CHAS. L. SHERWOOD

Scout

Cowley

K2 KANSAS

Map No. _____ Sec. *21* Twp. *31* R. *4*

Well No. *1 Goodrich*

Quinn State Oil Co. Company

Contractor

COMPLETED

SECTION PLAT

_____ Ft. from N. Line

330 Ft. from S. Line

_____ Ft. from E. Line

330 Ft. from W. Line

ABANDONED

Location _____

Rig up _____

Drilling and Remarks:

Location Abandoned

RECORD

Cased _____ in., _____ ft.

Sand _____

Gas _____

Oil _____

Total Depth _____

PRODUCTION

1st 24 hrs. Nat. _____

1st 24 hrs. after shot _____

Gas _____ Cu. Ft.

Dry Hole _____

Abandoned *Location*

Date

MAR 11 1926

CHAS. L. SHERWOOD

192

Scout