
Sedgwick

Form 51—5M—2-29—34703

Map No. KANSAS Sec. 6 Twp. 26 R. 1E

Well No. 5 Schurger Farm

Tidal Oil Company

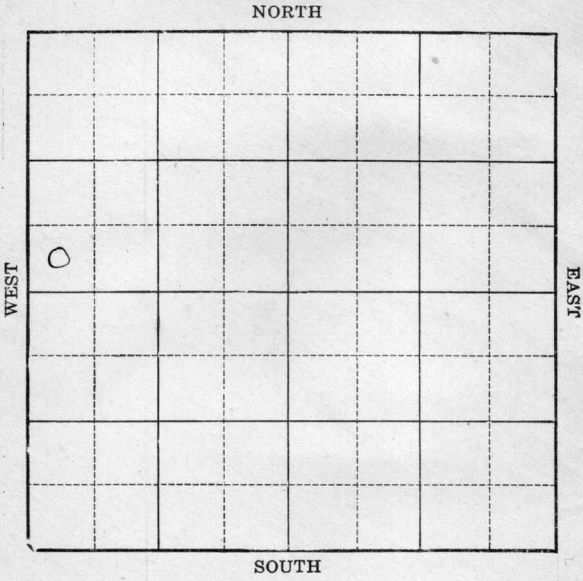

Location

Drilling Remarks

Rig Up

Drilling Remarks

RECORD

Cased in. ft.

Sand

Gas

Oil

Total Depth

PRODUCTION

1st 24 hrs. Nat.

1st 24 hrs. after shot

Gas cu. ft.

Dry Hole

Abandoned


Sedgwick

FORM 252A-5M-12-28-PETROL

Map No. KANSAS Sec. 6 Twp. 26 R. 1E

Well No. 3 - Schuyler Farm

Tidal Oil Company

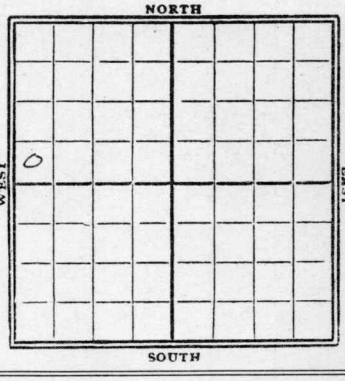

____ Ft. from N. Line

265 Ft. from S. Line

____ Ft. from E. Line

330 Ft. from W. Line

1929

Date	REPORT
4/17	Rig
4/24	Dkly 510'
5/1	" 1100'
5/8	" 1650'
5/15	" 2380'
5/22	" 2740'
5/29	" 3140
6/5	Rig tools 3183
6/12	Simpson 3367-71'
	T.D. 3371'
	swab 220 bbl oil
	Comp.

Form 26—1M Bks.—9-28

Sedgwick

KANSAS

13


Map No. ..... Sec. 6 Twp. 26 R. 1 E

Well No. 3 Schlegar

Tidal Oil Company

..... Contractor

SECTION PLAT

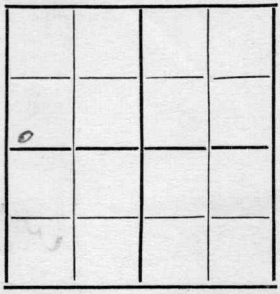

..... Ft. from N. Line

265 Ft. from S. Line

..... Ft. from E. Line

330 Ft. from W. Line

FIRST REPORTS

Location .....

Rig up .....

Drilling and Remarks:

Rig

RECORD

Cased ..... in., ... ft.

Sand .....

Gas .....

Oil .....

Total Depth .....

PRODUCTION

1st 24 hrs. Nat. .....

1st 24 hrs. after shot .....

Gas ..... Cu. Ft.

Dry Hole .....

Abandoned .....

Date

APR 17 1929

..... 192.....

S. J. LEWIS Scout

Form 26—1M Bks.—9-28

Sedgwick

Map No. KANSAS Sec. 6 Twp. 26 R. 1E


13

Well No. 8 Scherger

Tidal Oil Company

Contractor

SECTION PLAT

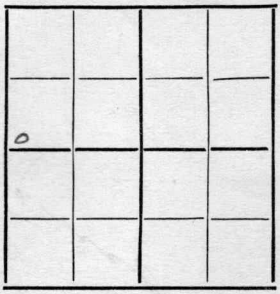

Ft. from N. Line

265 Ft. from S. Line

Ft. from E. Line

330 Ft. from W. Line

COMPLETED

Location

Rig up

Drilling and Remarks:

Simpson 3367

TD 3371

Plug 2100 ft

RECORD

Cased in., ft.

Sand

Gas

Oil

Total Depth 3371

PRODUCTION

1st 24 hrs. Nat.

1st 24 hrs. after shot

Gas Cu. Ft.

Dry Hole

Abandoned

Date

JUN 12 1929

192

S. J. LEWIS Scout

Form 26—1M Bks.—2-29

13 Beedwick E


Map No. KANSAS Sec. 6 Twp. 26 R. 1

Well No. 3 Scherger

Tidal Oil Co Company

Contractor

SECTION PLAT

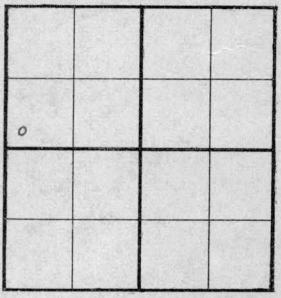

_____ Ft. from N. Line

765 Ft. from S. Line

_____ Ft. from E. Line

330 Ft. from W. Line

ABANDONED

Location _____

Rig up _____

Drilling and Remarks:

Plugged 4/11/31

RECORD

Cased _____ in., _____ ft.

Sand _____

Gas _____

Oil _____

Total Depth 3371

PRODUCTION

1st 24 hrs. Nat. _____

1st 24 hrs. after shot _____

Gas _____ Cu. Ft.

Dry Hole _____

Abandoned _____

Date

JAN 30 1932 CHAS. L. SHERWOOD

_____ 19 _____ Scout