


Map No. KANSAS Sec. 7 Twp. 26 R. 1E

Well No. 2 - Lyons Farm
Bu - U - Bar Company

_____ Ft. from N. Line
990 Ft. from S. Line
_____ Ft. from E. Line
330 Ft. from W. Line

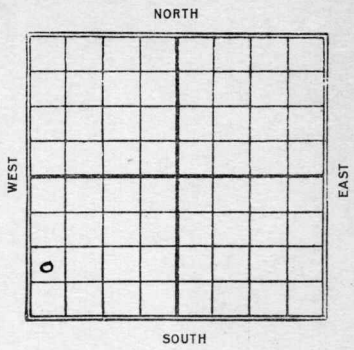

1928

Date	REPORT
9/19	Roll
9/26	Bldg Rig
10/3	Rign up
10/10	d rly 450'
10/17	" 1280'
10/24	" 1850'
10/31	" 2137' = 10" at 2125'
11/7	show oil 2580-90' d rly 2800'
11/14	T.D. 3001' - U/R 8"
11/21	Top chat 3010 - show oil 3028-30' d rly 3055'
11/30	" 3310' - BL - 3220' run 6" to - rite Will drill in Mon or Tue.
11/28	Made 1765 bbls. Telegram.
12/6	Top pay 3352 T.D. 3359 Est. at 35 bbls an hr.
12/7	534 bbls 1st 16 hrs
12/8	786 " oil

12/9 made 782 bbls
 12/10 " 765 "
 12/11 " 768 "
 12/12 " 790 "
 12/13 " 753 "

12/12 Pay 3352-59
 T.D. 3359'

flowing 786 bbls 24 hrs
 Pump

12/14 - 763 bbls 3/25 - 320 bbls.
 12/15 - 819 " 3/26 - 300 "
 12/16 753 " 3/28 - 240 "
 12/17 813 " 4/1 - 273 "
 12/18 686 " 4/5 - Off -
 12/19 748 " To swab
 12/20 842 "
 12/21 577 "
 12/29 715 "
 1929
 1/25 628 "
 1/28 661 "
 1/28 572 "
 1/29 652 "
 2/1 651 "
 2/2 674 "
 2/4 685 "
 2/7 706 "
 2/8 684 "
 2/16 675 "
 2/20 625 "
 2/21 1115 "
 2/23 568 "
 2/26 553 "
 3/5 496 "
 3/7 494 "
 3/8 483 "
 3/11 445 "
 3/12 445 "
 3/14 421 "
 3/16 411 "
 3/18 390 "
 3/19 383 "
 3/21 362 "
 3/22 385 "
 3/23 367 "

Seelye
K13

MAP NO. **KANSAS** SEC. 7 TWP. 26 R. 1E

WELL NO. 2 Lyons

Bu-Hi-Bar COMPANY

CONTRACTOR

SECTION PLAT

0			

_____ FT. FROM N. LINE

990 FT. FROM S. LINE

_____ FT. FROM E. LINE

330 FT. FROM W. LINE

FIRST REPORTS

LOCATION _____

RIG UP _____

DRILLING AND REMARKS:

ROG

RECORD

CASED _____ IN., _____ FT.

SAND _____

GAS _____

OIL _____

TOTAL DEPTH _____

PRODUCTION

1ST 24 HRS. NAT. _____

1ST 24 HRS. AFTER SHOT _____

GAS _____ CU. FT.

DRY HOLE _____

ABANDONED _____

DATE

SEP 19 1928

SCOUT

Seelgwick
MAP NO. KANSAS SEC. 7 TWP. 26 R. 15

WELL No. 2 Lyons

Bu Ki Bar COMPANY

CONTRACTOR

SECTION PLAT

0			

_____ FT. FROM N. LINE

990 FT. FROM S. LINE

_____ FT. FROM E. LINE

830 FT. FROM W. LINE

COMPLETED

LOCATION _____

RIG UP _____

DRILLING AND REMARKS:

*Pay 3352 &
2859*

786 ft

24 hrs of logging

RECORD

CASED _____ IN. _____ FT.

SAND _____

GAS _____

OIL _____

TOTAL DEPTH 3359

PRODUCTION

1ST 24 HRS. NAT. _____

1ST 24 HRS. AFTER SHOT _____

GAS _____ CU. FT.

DRY HOLE _____

ABANDONED _____

DATE

DEC 12 1928

192

S. J. LEWIS

SCOUT