


KANSAS

Section 7 Township 26S Range 1E

Well No. #1 Lyon

Company S. Springer

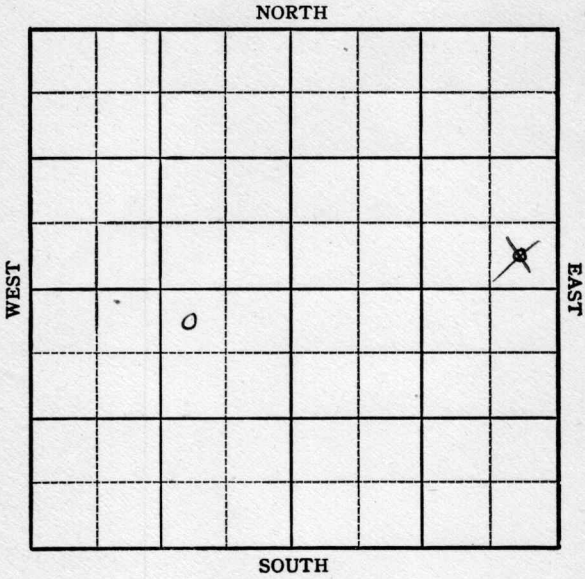

Sec. 7 Twp. 26 R. 1E

Well No. #1 Lyon Farm

S. Springer Company

Miscellaneous (Allison, Cont.)


330' Ft. from N. Line

_____ Ft. from S. Line

990' Ft. from E. Line

_____ Ft. from W. Line

NW NE SW

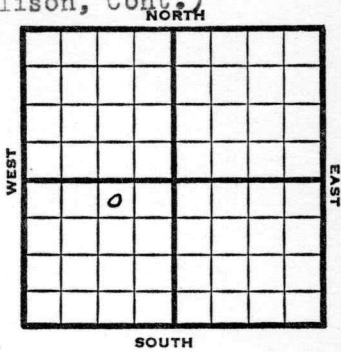

1949

REPORT

9/14 Surface Hole

9/21 Viola 3367'
TD 3369'
5" @ 3368'

10/5 Viola 3367'
TD 3369'
Abd.

ABANDONED

Map No. _____ Sec. 7 Twp. 26 R. 1E

Well No. 1 Lyon

S. Springer Company

Allison Contractor

NW NE SW

SECTION PLAT

330 Ft. from N. Line

_____ Ft. from S. Line

990 Ft. from E. Line

_____ Ft. from W. Line

	8		

Sedgwick County

RECORD

Location _____

Cased _____ in., _____ ft.

Rig up _____

Sand _____

Drilling and Remarks:

Gas _____

surface hole

Oil _____

Total Depth _____

PRODUCTION

1st 24 hrs. Nat. _____

1st 24 hrs. after shot _____

Gas _____ Cu. Ft.

Dry Hole _____

Abandoned _____

Date

SEP 14 1949

19

S. J. LEWIS

Scout

Map No. _____ Sec. 7 Twp. 26 R. 1E

Well No. 1 Lyon

S. Springer Company

ABANDONED

Contractor

NW NE SW

SECTION PLAT

330 Ft. from N. Line

_____ Ft. from S. Line

990 Ft. from E. Line

_____ Ft. from W. Line

	o		

Sedgwick County

RECORD

Location _____

Cased _____ in., _____ ft.

Rig up _____

Sand _____

Drilling and Remarks:

Gas _____

No La 3367

Oil _____

Total Depth 3367

PRODUCTION

1st 24 hrs. Nat. _____

1st 24 hrs. after shot _____

Gas _____ Cu. Ft.

Dry Hole _____

Abandoned _____

Date

OCT 5 1949

19

S. J. LEWIS

Scout