Form 51—5M—11-38—Palace

Cowley

KANSAS

Section 21 Township 31 Range 4-E

Well No. 2 Waite

Company Barnett & Connelly

Hittle Pool

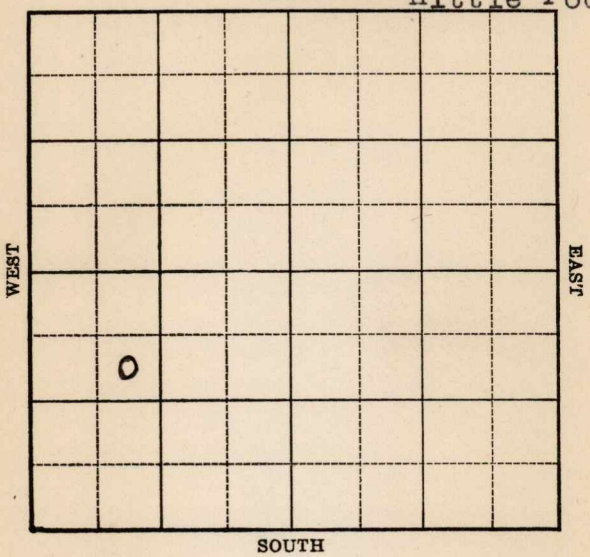

FORM 252-A 5M 10-38 KANSAS Cowley

Sec. 21 Twp. 31 R. 4-E

Well No. #2 Waite Farm

Barnett & Connelly Company

(Hittle)

990 Ft. from N. Line

Ft. from S. Line

Ft. from E. Line

990 Ft. from W. Line

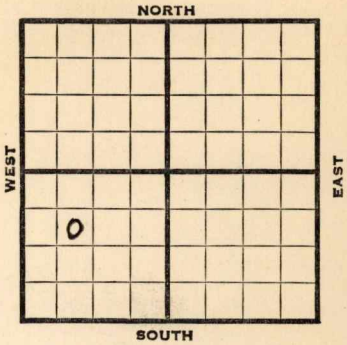

Elev. 1245

1939	REPORT
4/26	Cellar.
5/5	R. R.
5/12	"
5/19	10" - 86' WOC.
5/26	K. C. 2472' Drlg. 2515'
6/1	Arb. 3350' T.D. 3353'
	Flowed 45 bbls. per hour.
6/7	Arb. 3350 7" 3339
	T.D. 3357
	Bottom hole bomb pot. 8623
	COMPLETED

Form 26—1M Bks.—2-29

Cowley KANSAS

Map No. 2 Sec. 21 Twp. 31 R. 4E

Well No. 2 Waite

Barnett & Connelly Company

Contractor

FIRST REPORT

SE NW SW

990 Ft. from N. Line

Ft. from S. Line

Ft. from E. Line

990 Ft. from W. Line

HITTLE POOL

SECTION PLAT

O			

Location

Rig up

Drilling and Remarks:

Cellar

RECORD

Cased in., ft.

Sand

Gas

Oil

Total Depth

PRODUCTION

1st 24 hrs. Nat.

1st 24 hrs. after shot

Gas Cu. Ft.

Dry Hole

Abandoned

Date

APR 26 1939 19

H. D. Hatfield Scout

KANSAS

Form 26—1M Bks.—2-29

Cowley

Map No. 2 Sec. 21 Twp. 31 R. 4E

Well No. 2 Waite

Barnett & Connelly Company

Contractor

COMPLETED

SE NW SW

990 Ft. from N. Line

Ft. from S. Line

Ft. from E. Line

990 Ft. from W. Line

HITTLE POOL

SECTION PLAT

0			

Location

Rig up

Drilling and Remarks:

Cer. 3350

7" @ 3339.

Bottom Hole Bowl

Po & 8623

RECORD

Cased in., ft.

Sand

Gas

Oil

Total Depth 3357

PRODUCTION

1st 24 hrs. Nat.

1st 24 hrs. after shot

Gas Cu. Ft.

Dry Hole

Abandoned

Date

JUN 7 1939 19

S. J. LEWIS Scout