

Section 4 Township 18 Range 14-WWell No. #4 SchugartCompany Continental Oil

NORTH

12

0							

SOUTH

WEST

EAST

Barton **KANSAS**

Sec. 4 Twp. 18 R. 14W

Well No. #4 Schugart Farm

Continental Oil Company

Boyd Pool Contractor


330' Ft. from N. Line

 Ft. from S. Line

 Ft. from E. Line

330' Ft. from W. Line

NW NW SW

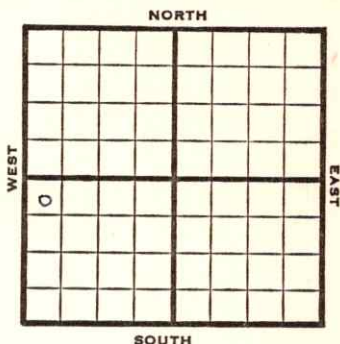

1950

Elev. 2003

R E P O R T

12/27

MIRT

1951

1/31

Spud 12/26/50

Oil well TD 3497

12" @196

Anhy 970

9" @972

Lans. 3247 Arb. 3483

TD 3497

7" @3484 FU 500' oil 1 hr. S/ 46 bo
3 hr.

Comp. 468 bopd

COMPLETED

County Barton State KansasSec. 4 (Blk.) 18 (Sur.) 14W Map No.Operator Continental OilWell No. 4 Farm SchugartElev. Location NW NW SW330 Ft. From N Line SW330 Ft. From W Line Quarter1st. Report DEC 27 1950

Completion

Remarks

Spudding Date

Drlg. Data Boyd PoolMIRT

J. E. TYRA

Sec. 4 (Blk.) 18 (Sur.) 14W Map No.

Well No. 4 Farm Schugart

Elev.	2003	Location	NW	NW	SW
-------	------	----------	----	----	----

330 Ft. From N Line SW

330 Ft. From W Line Quarter

1st. Report

Completion JAN 31 1951

Remarks	Boyd Pool
---------	-----------

Spudding Date 12-26-50

Drig. Data Oil well TD 3497

13" @ 196 Anhy 970 9" @ 972

Lans. 3247 Arb. 3483 TD 3497

7" @ 3484 FU 500' oil 1 hr. S/ 46 bo 3hr.

Comp. 468 bopd

J. E. TYRA